Name Sven Dahlquist **Service No.**

Address 29 Farmcrest Avenue

Location

Kind of Pipe **Size** **Size of Main**

~~Repair~~—Renewal—~~New Service~~ Valeri #3584 W.O.#1198 **Location**

Date		Material	Amount		Total		Date			Amount	
6-23-80	24'	6" Transite pipe									
									OUTSIDE		
							6-6-80		Labor		
								2	6" x 10' Transite pipe		
								1	6" x 5' " "		
								1	6" Cap		
								1	6 x 8 C.I. Saddle & Strap		
								1	6" x 22½° Bend		
								3	hrs. Trucking		
								4	hrs. Town Shovel		
									Patch 7' x 18'		
							10/23/84	1	6"X6" Fernco - AC to PVC-W.O.#988		
								1	6" x 22½ AC° Bend		
							2-18-	70	Roots		

DATE _____

TOWN OF LEXINGTON — BOARD OF PUBLIC WORKS

SEWER DIVISION

Sketch of Service Here 29

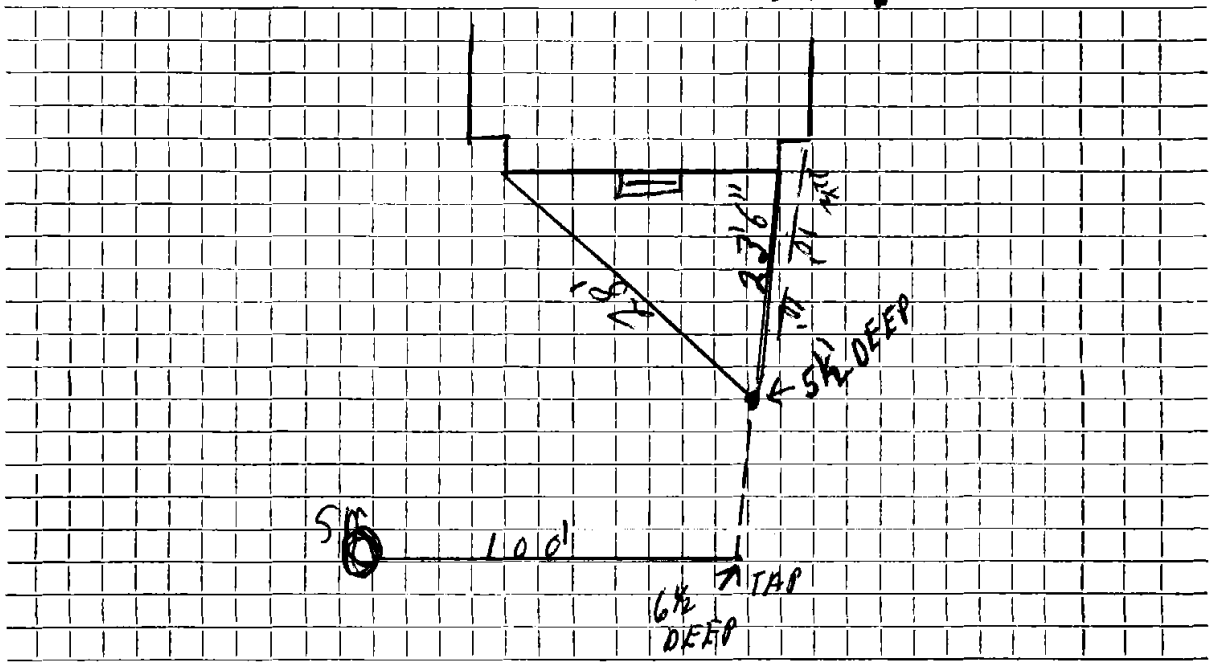

Connection made in ..... Street. Work completed .....

Remarks: A PIPE IS STANDING AT END OF PIPE