Name

Service No. 3215

Address 47 Farmcrest Ave

Location

Kind of Pipe PVC

Size 6"

Size of Main

Repair—Renewal—New Service J Melaughlin

Location Lot 202

Date		Material	Amount	Total	Date		Amount
3/6/09	6'	4" Sch.40					
	1	4x6 Ferrnco					
	1	6" PVCxAC-Ferrnco 4' pon					
	50'	6"-PVC					
		out					
Exist	19'	6"A.C.					
3/30/70	2	Adaptors					
	1	90° Elbow					
	1	1'-0 Nipple					

DATE _____

TOWN OF LEXINGTON — BOARD OF PUBLIC WORKS

SEWER DIVISION

Sketch of Service Here

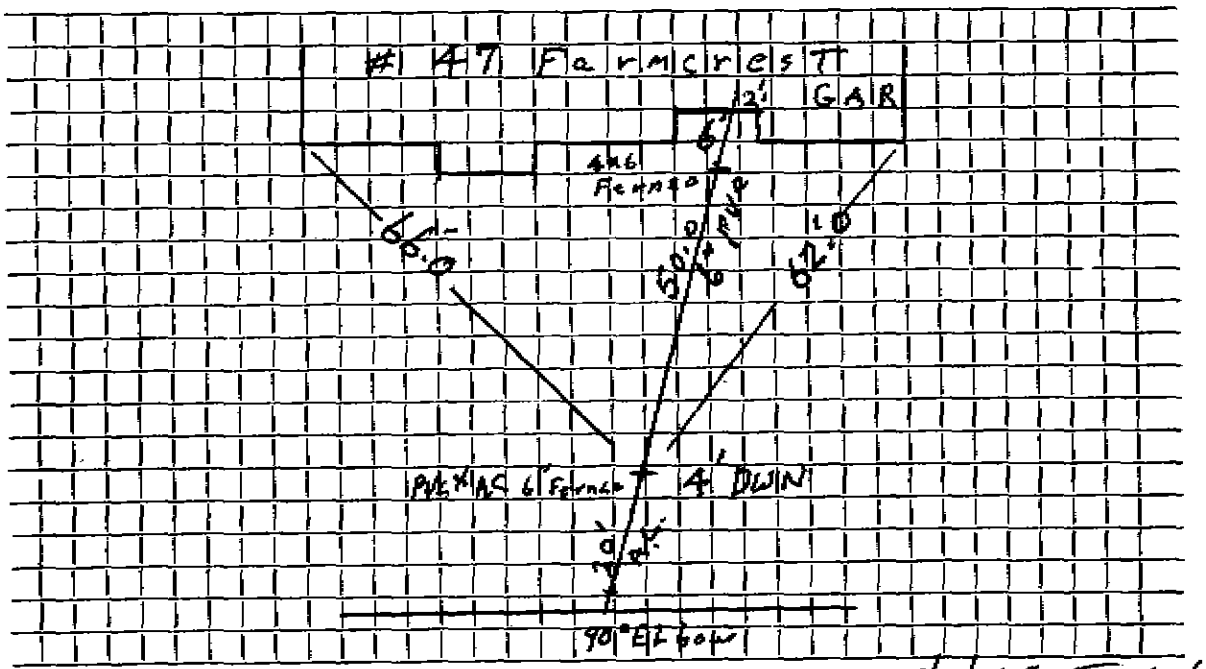

Connection made in ..... Street. Work completed 3/6/09 J. McLaughlin

Remarks: .....

.....

.....