[redacted]

Name Leopold **Service No.**

Address 40 FERN ST.

Location

Kind of Pipe **Size** **Size of Main**

Repair—Renewal—New Service Banks # 229 **Location**

Date	Material	Amount	Total	Date		Amount
8/31/93	65 LF 4" CI					
	PRE-CAST SMH					
	2 - 4" CICO					

DATE 1/5/94

TOWN OF LEXINGTON — BOARD OF PUBLIC WORKS

SEWER DIVISION

Sketch of Service Here **40**

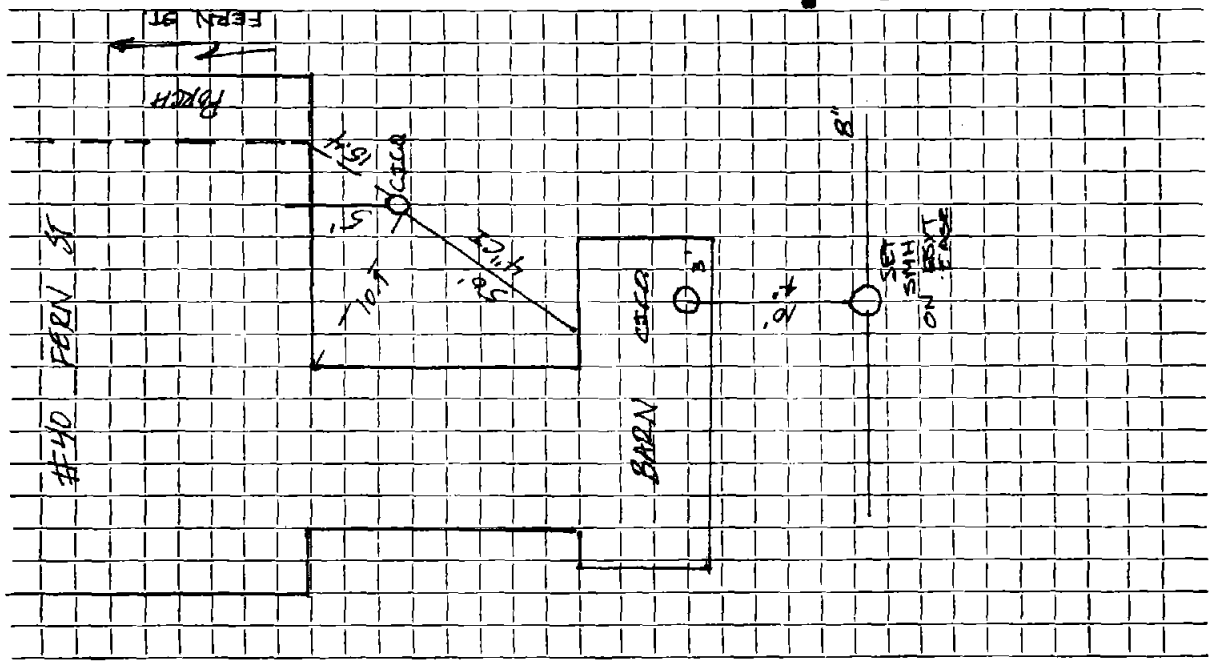

Connection made in ..... Street. Work completed 8/31/93 E.R. BANKS

Remarks: .....