[redacted]

Name Leonard Notkin **Service No.** 100

Address 1 Field Road

Location

Kind of Pipe **Size** **Size of Main**

Repair—Renewal—New Service Lexington Sewerage #1966 **Location** APR 26 1972

Date		Material	Amount	Total	Date			Amount
~~1971~~	~~15'~~	~~6" Transite pipe~~ @	12.00	180.00	11-4-71		Deposit	180 00
11-27-71	74'	6" Transite pipe				1971		
	10'	4" Cast Iron				15'	6" Transite	

I.M.18501

DATE _____

TOWN OF LEXINGTON — BOARD OF PUBLIC WORKS

SEWER DIVISION

Sketch of Service Here

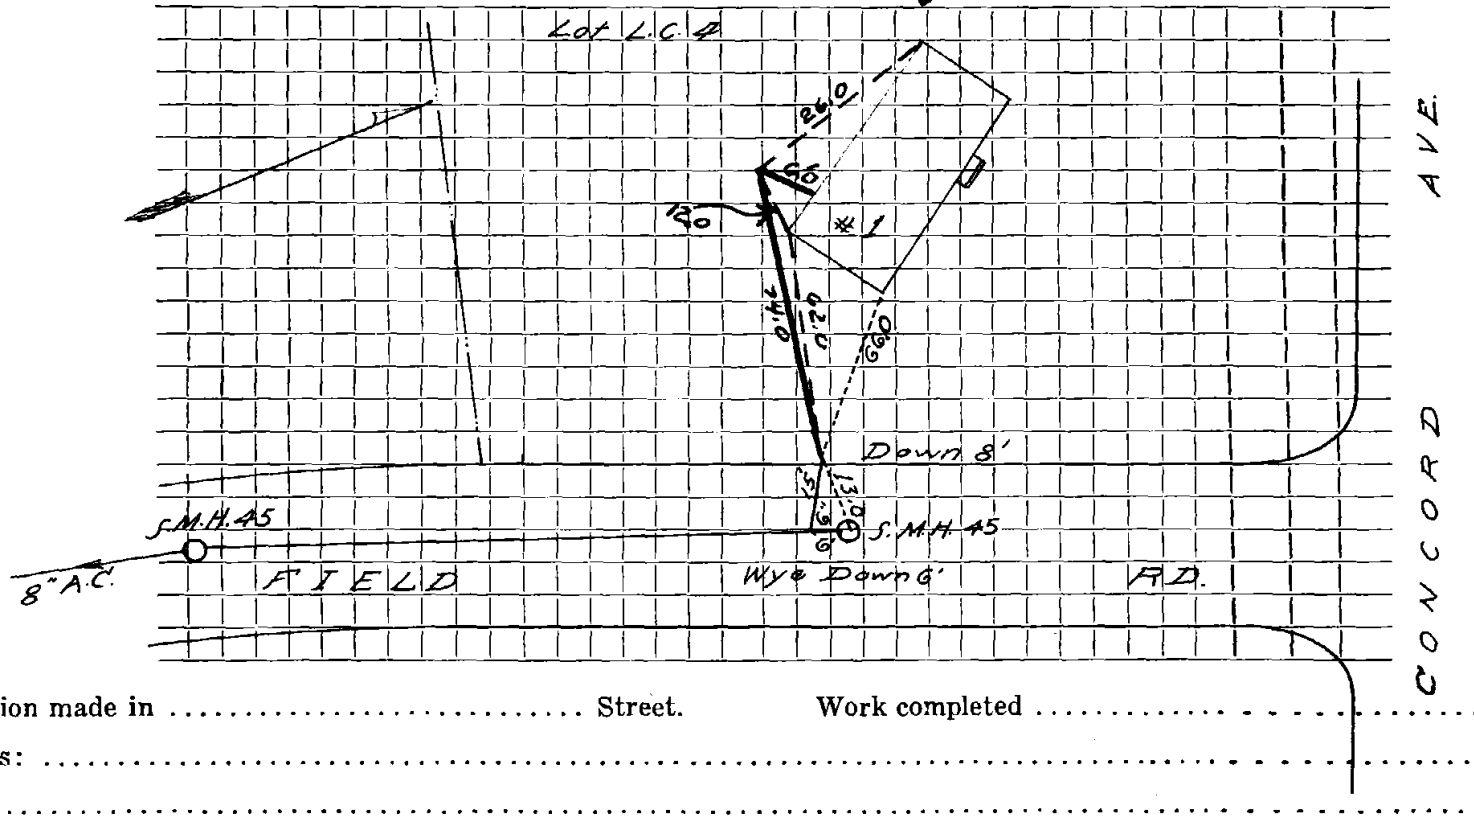

Connection made in ..... Street. Work completed .....

Remarks: .....

.....

.....