Name Robert Kingston **Service No.** 109

Address 4 Field Road

Location [illegible]

Kind of Pipe **Size** **Size of Main**

Repair—Renewal——New Service Lexington Sewerage #1955 **Location** APR 26 1972

Date	Material	Amount	Total	Date			Amount
~~1971~~ ~~25'~~	~~6" Transite pipe~~ @ 12.00		300.00	11-11-71		Deposit	300 00
11-20-71 126'	6" Transite pipe						
10'	4" Cast Iron pipe						
					1971		
					25'	6" Transite	

B.M.18501

DATE _____

TOWN OF LEXINGTON — BOARD OF PUBLIC WORKS

SEWER DIVISION

Sketch of Service Here 4

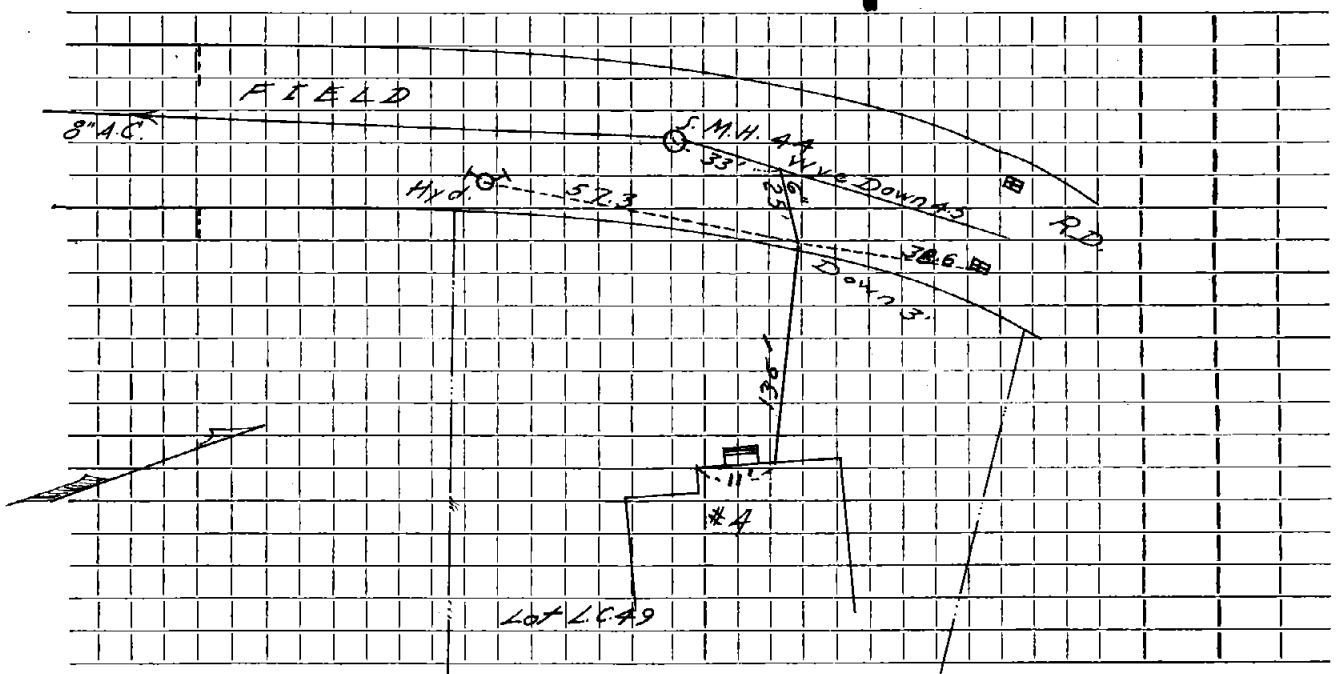

Connection made in ..... Street. Work completed .....

Remarks: .....

.....

.....