[redacted]

Name **Service No.**

Address 9 Fiske Rd

Location

Kind of Pipe **Size** **Size of Main**

Repair—Renewal—New Service **Location**

Date	Material	Amount	Total	Date		Amount
4-14-98 -	55'-6" PVC			12-6-00	Outside	
					24'-6" PVC	
					1-8x8x6 Tee	
					1-6" Elbow	
					1-6" PVC-PVC Ferneo	
					2-8" CI-PVC Ferneo	
					2'-8" PVC Pipe	

[redacted]

DATE 4-14-98

TOWN OF LEXINGTON — BOARD OF PUBLIC WORKS

SEWER DIVISION

Sketch of Service Here

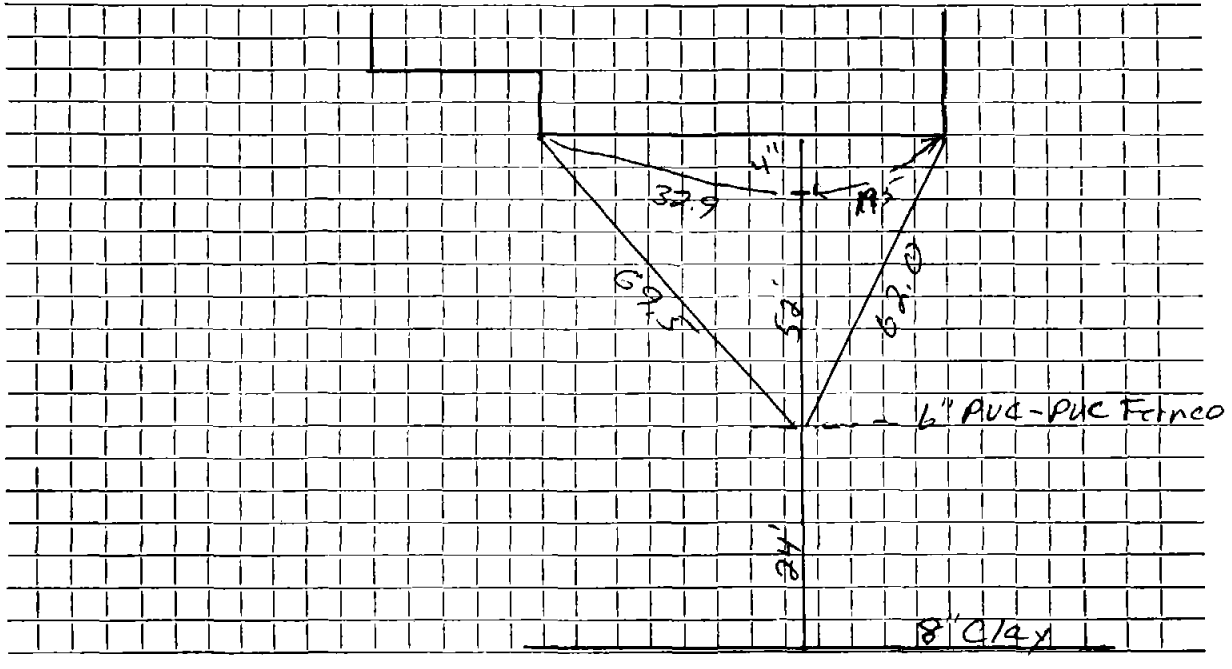

Connection made in ..... Street. Work completed 12-6-00

Remarks: .....

Field Book 98-1