[redacted]

Name JEFFERSON UNION COMPANY **Service No.**

Address 31 FLETCHER STREET

Location

Kind of Pipe P. V. C. **Size** 6" **Size of Main**

Repair—Renewal—New Service PERMIT NO 1178 **Location**

Date		Material	Amount		Total		Date			Amount	
OCT 29	98	101' 6" P.V.C.									
		1 4"x6" FERNCO									
		PERMIT FEE PAID	$100	00							

DATE OCT 29 1998

TOWN OF LEXINGTON — BOARD OF PUBLIC WORKS

SEWER DIVISION

Sketch of Service Here

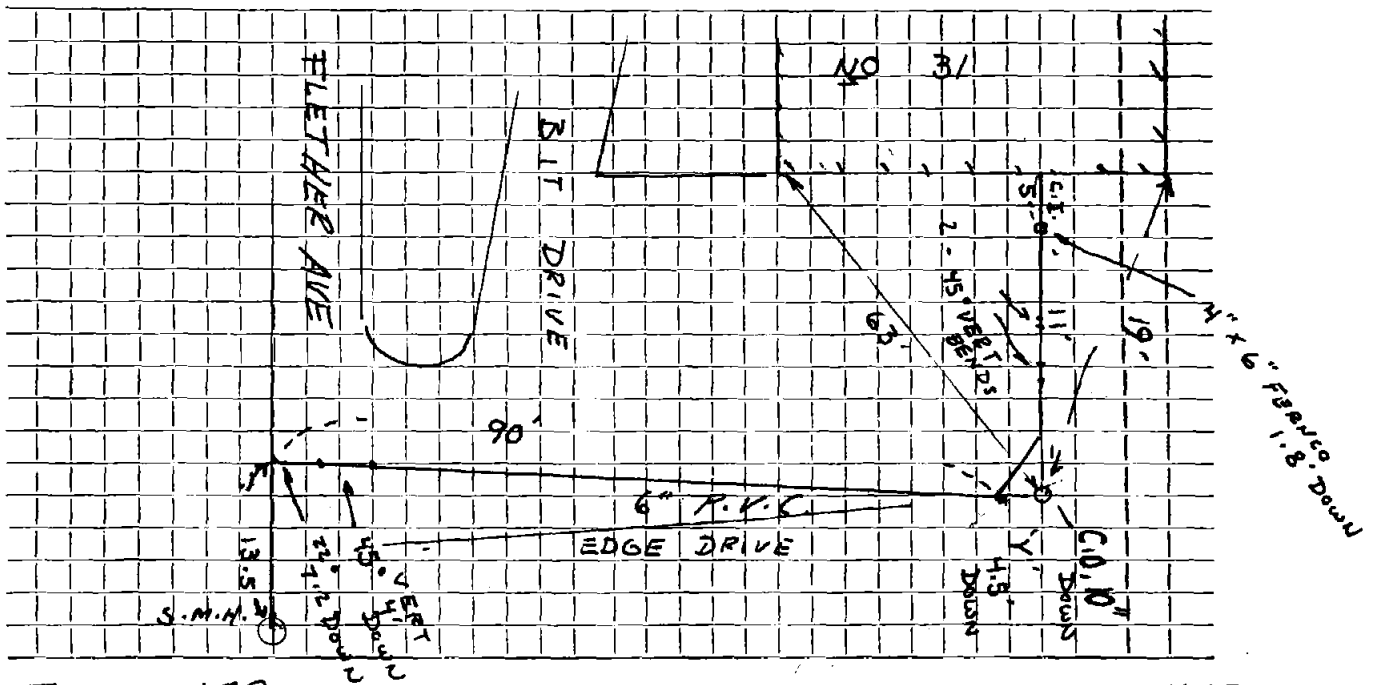

Connection made in FLETCHER Street. Work completed BRUCE MCKEE

Remarks: