Name **Service No.**

Address 20 FLINTLOCK RD

Location

Kind of Pipe **Size** **Size of Main**

Repair—Renewal—New Service JIM McLAUGHLIN **Location**

Date		Material	Amount		Total		Date			Amount	
7/16/98	6'	4" PVC									
	36'	6" PVC									
	2	6" 22° BENDS									
	1	4X6 FERNCO									
	1	PVC-AC FERNCO									
	EXISTING	AC ON ST									

DATE _____

TOWN OF LEXINGTON — BOARD OF PUBLIC WORKS

SEWER DIVISION

Sketch of Service Here

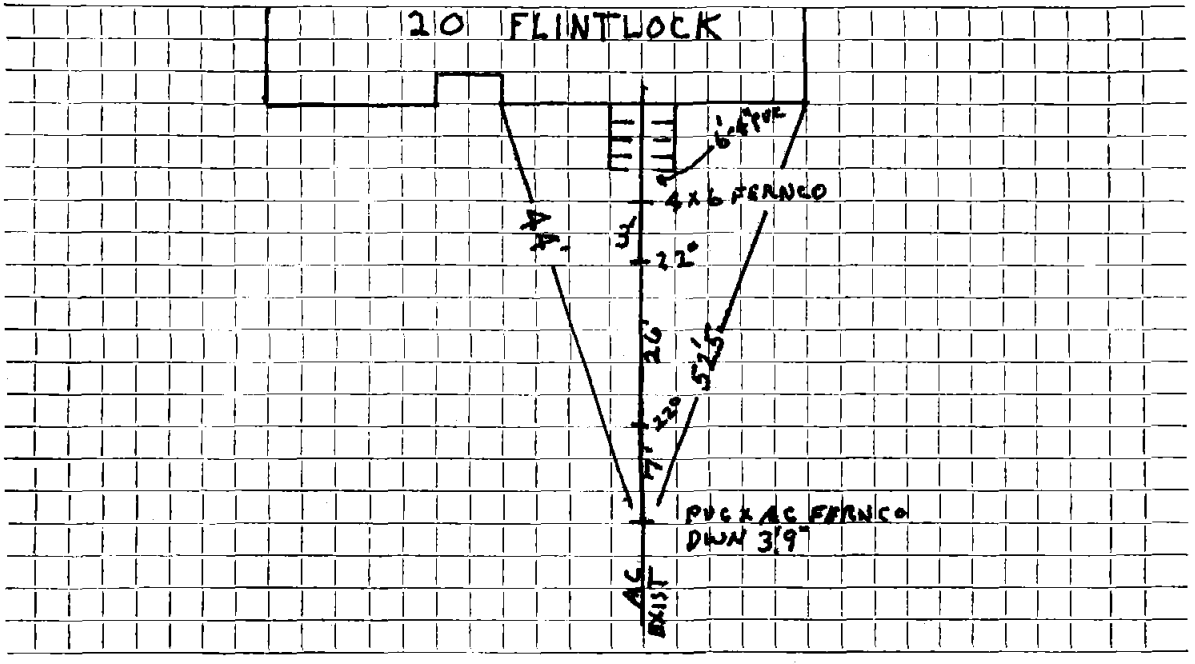

Connection made in ..... Street. Work completed .....

Remarks: .....

.....