Name **Service No.**

Address 6 Fl ntlock Road

Location

Kind of Pipe **Size** **Size of Main**

~~Repair Renewal~~ New Service **Location**

Date		Material	Amount		Total		Date			Amount	
Dec. 1953		66' - INSTALLED BY DEVELOPER									
		Labor									

HP-7919

TOWN OF LEXINGTON—DEPT. OF PUBLIC WORKS

SEWER DIVISION

DATE ..... NO. .....

The undersigned applies for the construction of a particular sewer connecting No. ..... - - - ..... Street and hereby agrees to comply with the Rules and Regulations governing the construction and use of Particular Sewers, as now or at any future time established by the Board of Selectmen.

Am't of estimate $.....

Am't Paid $.....

..... - - - ..... Owner

Sketch of Service Here

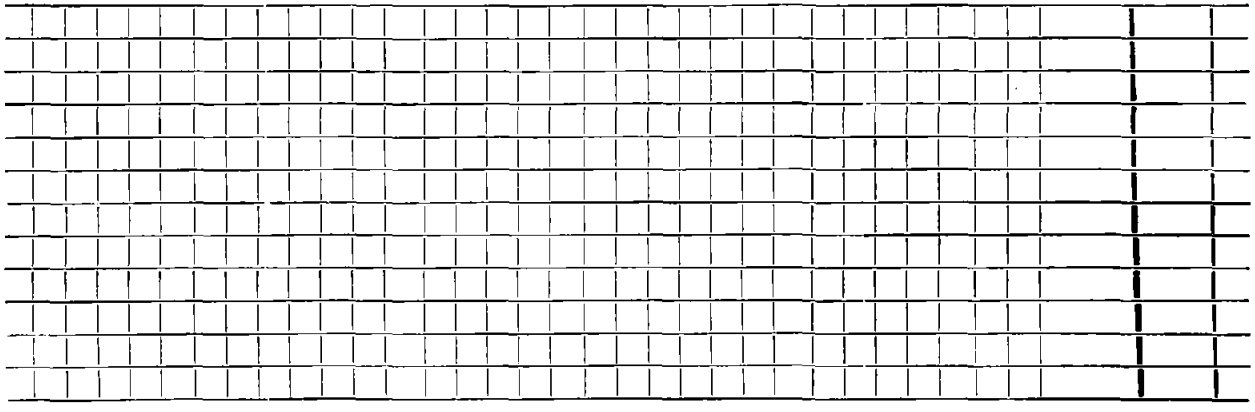

Connection made in ..... Street. Work completed .. — - - - ..... 19..

Remarks: