Name Arthur Smith **Service No.** 230

Address 51 Follen Road

Location

Kind of Pipe Craftsmen Inc. Permit #A82 **Size** **Size of Main**

~~Repair~~ ~~Renewal~~ ~~Extra~~ **New Service** **Location** MAY 2 1966

Date		Material	Amount	Total	Date			Amount
~~1965~~	~~26'~~	~~6" Transite pipe~~ @ 5.00		130.00	11-10-65		Report	130 00
12/10/65	17'	6" Transite pipe				1965		
12/10/65	20'	4" Cast Iron Pipe				26'	6" Transite	

8.M.18501

DATE _____

TOWN OF LEXINGTON — BOARD OF PUBLIC WORKS

SEWER DIVISION

Sketch of Service Here 51

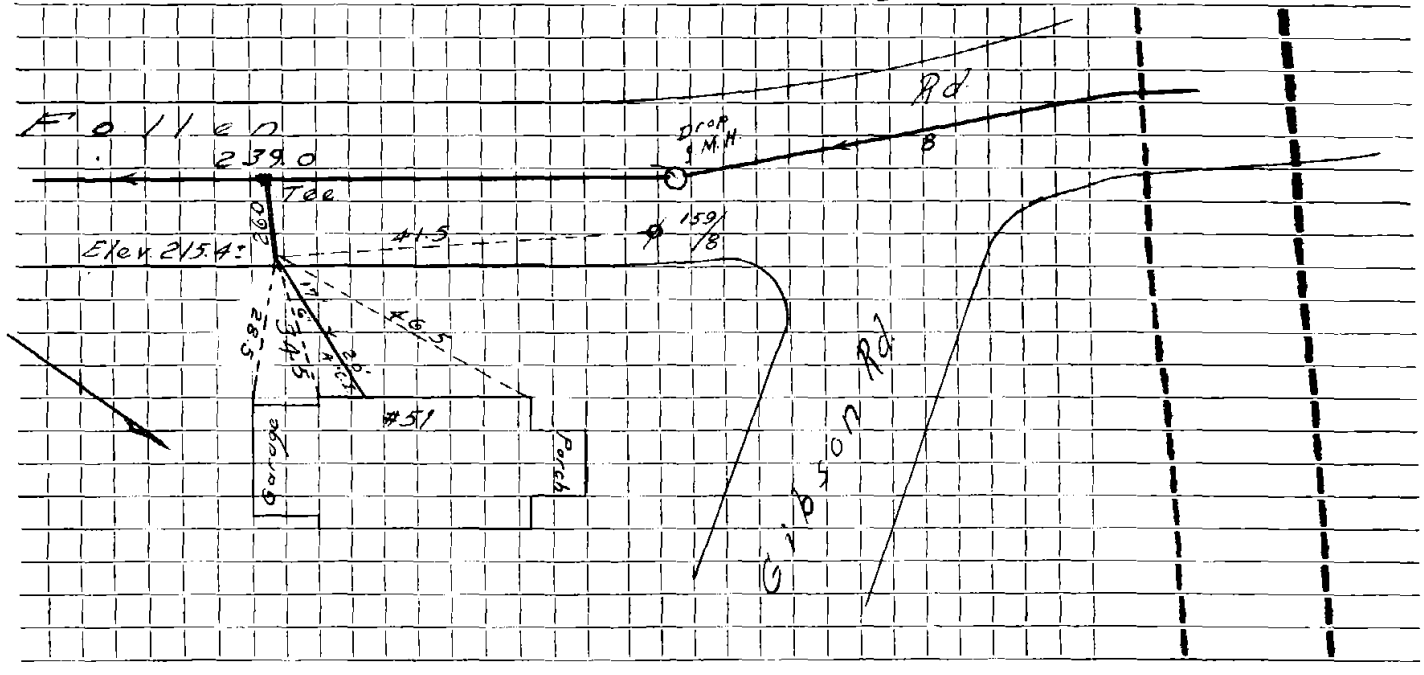

Connection made in ..... Street. Work completed .....

Remarks: .....

.....

.....