Name Robert Bowers **Service No.** 256

Address 65 Follen Road

Location

Kind of Pipe Craftsmen Inc. Permit #A158 **Size** **Size of Main**

~~Repair Renewal~~ x **New Service** **Location** MAY 2 19[illegible]

Date		Material	Amount	Total	Date			Amount
~~965~~	~~53'~~	~~6" Transite pipe @5.00~~		265.00	12-14-65		Payment	265.00
2/31/65	36'	6" Transite pipe				1965		
						53'	6" Transite	

B.M.18501

DATE

TOWN OF LEXINGTON — BOARD OF PUBLIC WORKS

SEWER DIVISION

Sketch of Service Here 65

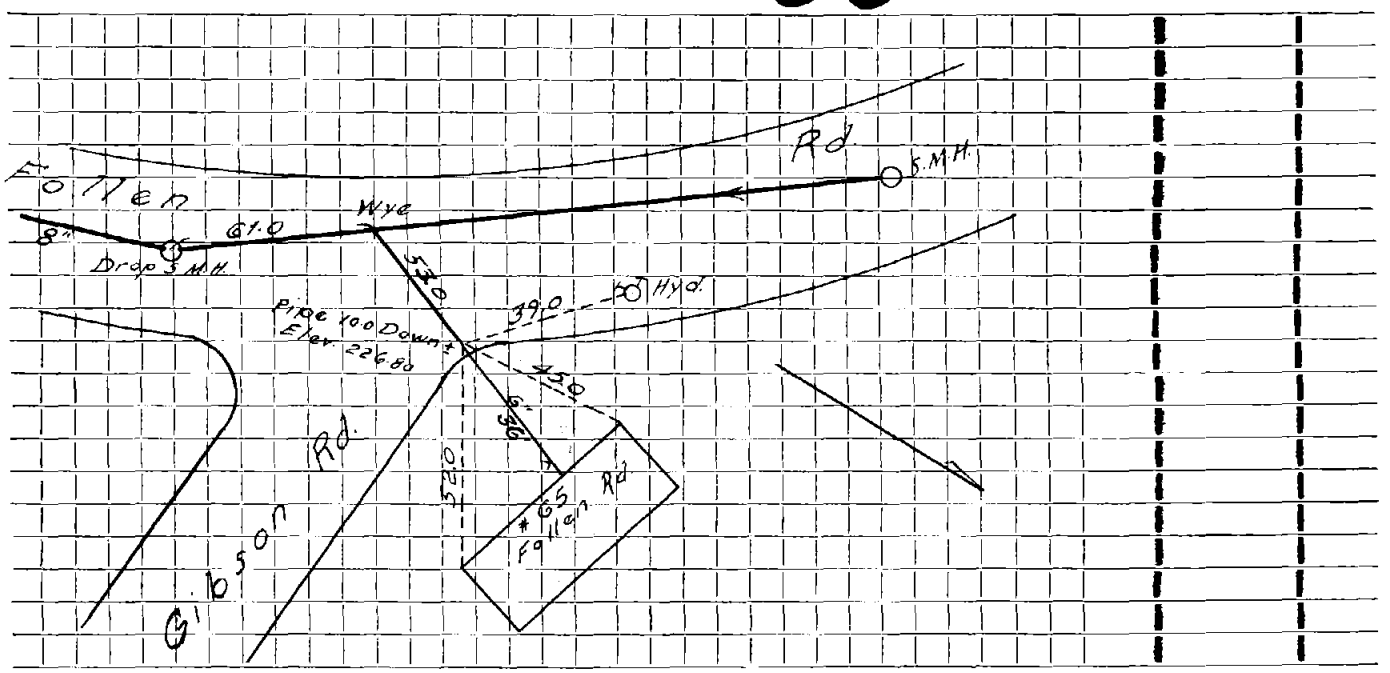

Connection made in ..... Street. Work completed .....

Remarks: .....

.....

.....