[redacted]

Name **Service No.**

Address 16 Forest ST

Location

Kind of Pipe PVC **Size** 6" **Size of Main**

Repair **Renewal** **New** **Service** J Mcloughlin **Location**

Date		Material	Amount	Total	Date		Amount
		NEW SERVICE					
2004	4.0'	4" Sch 40					
	41.0'	6" PVC					
	1	6"x4" Fernco					
	1	6" wye					
		Exist. Renewal					
		" 4" Cast Iron					
	1	4x6" Fernco					
	71.0'	6" PVC					
	1	6" Clayx Pvc Fernco					

DATE _____

TOWN OF LEXINGTON — BOARD OF PUBLIC WORKS

SEWER DIVISION

Sketch of Service Here

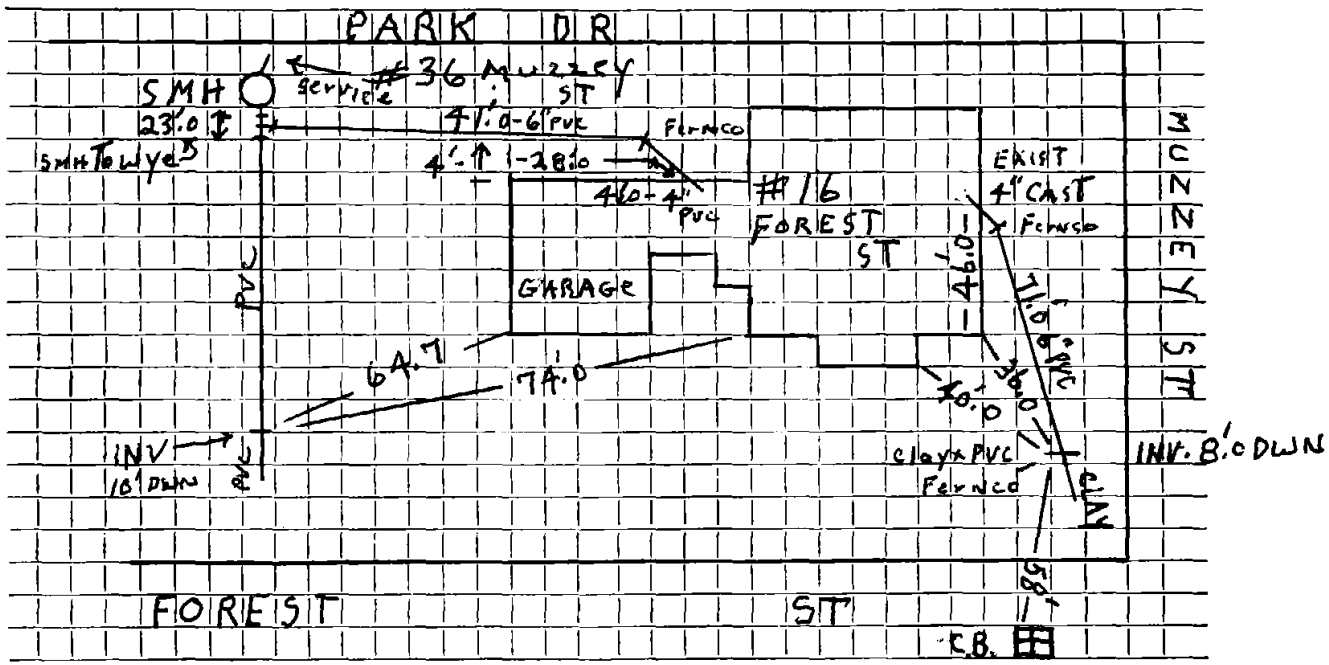

Connection made in ..... Street. Work completed ....2004 J. McLaughlin....

Remarks: 16 Forest and 36 Muzzey use same 6" PVC To ST.