[redacted]

Name Walter Gougian **Service No.** 172

Address 16 Foster Road

Location Comm. 11-18-57

Kind of Pipe **Size** **Size of Main**

~~Repair Renewal~~ **New Service** **Location**

Date	Material	Amount	Total	Date		Amount
10-3-57	Labor	28.68		9-30-57	Deposit	$ 100.00
	10 % O.H.	2.87	31.55	11-18-57	Refund	16.50
	46' 6" Transite pipe @.70		32.20			$ 83.50
	2 hrs. Town Shovel @ 6.50		13.00			
	1 hr. Rodgers Trailer @ 3.00		3.00			
	1 hr. trucking @ 3.00		3.00			
	1 hr. trucking @.75		.75			
			83.50			
	Labor					

HP-6411

TOWN OF LEXINGTON—DEPT. OF PUBLIC WORKS

SEWER DIVISION

DATE ..... NO. .....

The undersigned applies for the construction of a particular sewer connecting No. ..... Street and hereby agrees to comply with the Rules and Regulations governing the construction and use of Particular Sewers, as now or at any future time established by the Board of Selectmen.

Am't of estimate $.....

Am't Paid $.....

..... Owner

Sketch of Service Here

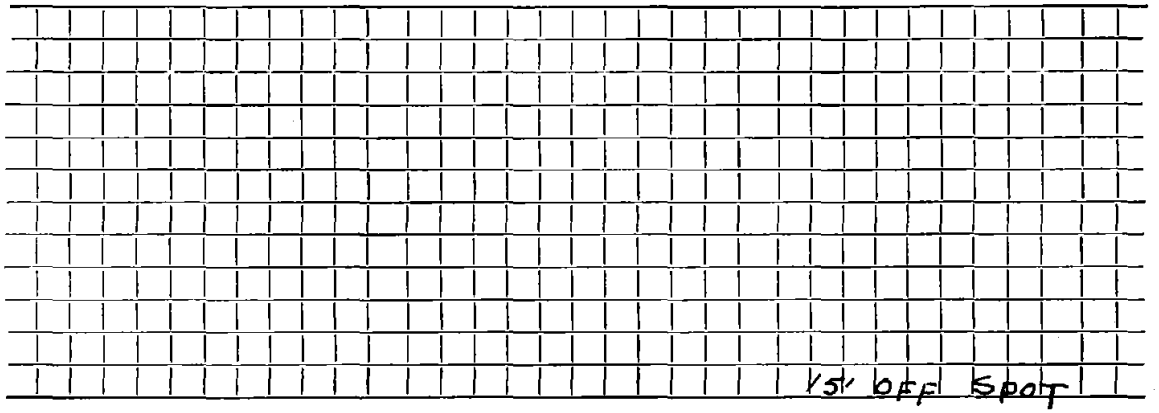

Connection made in ..... Street. Work completed ..... 19..

Remarks: