Name Arnold G. Kramer **Service No.** 108

Address 9 Fulton Road

Location Lot 45

Kind of Pipe **Size** **Size of Main**

Repair—Renewal—New Service Valeri #1758 **Location** APR 2 1 1971

Date		Material	Amount		Total		Date			Amount	
~~Nov '70~~	~~25'~~	~~6" Transite pipe~~ @7	.50		187	.50	10-26-70		Deposit	187	50
10/27/70	52'	6" Transite									
	5'	4" Cast Iron pipe					11- -	70			
								25'	6" Transite		

I.B.M.18501

DATE _____

TOWN OF LEXINGTON — BOARD OF PUBLIC WORKS

SEWER DIVISION

Sketch of Service Here **9**

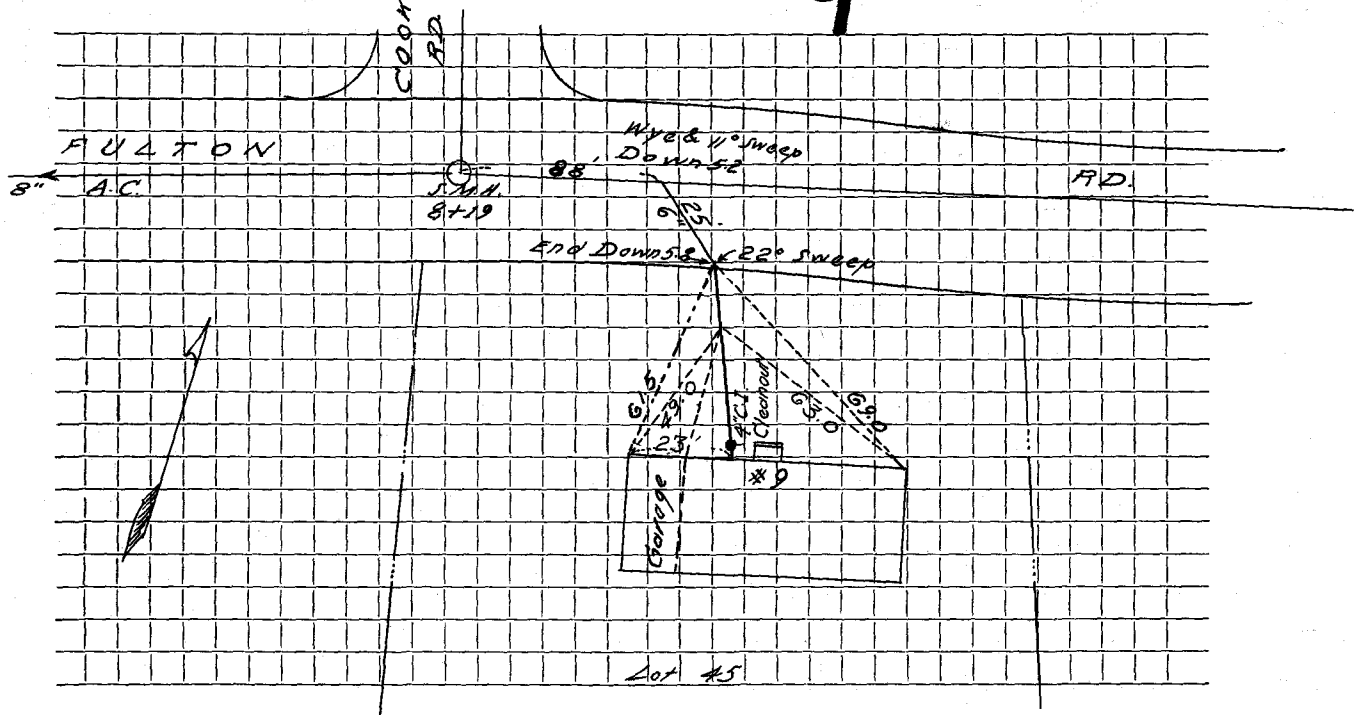

Connection made in ..... Street. Work completed .....

Remarks: .....

.....

.....