Name **Service No.** 1943

Address 13 Gleason RD

Location

Kind of Pipe PVC **Size** 6" **Size of Main**

Repair—Renewal—New Service T.D. J McLaughlin **Location**

Date		Material	Amount	Total	Date		Amount
11/9/05	6'	4" Sch 40 PVC					
	45'	6" PVC					
	1	4x6 Ferrco					
	1	6" Clay x PVC-Ferrco					
10/19/53	26'	Exist Clay					

DATE _____

TOWN OF LEXINGTON — BOARD OF PUBLIC WORKS

SEWER DIVISION

Sketch of Service Here

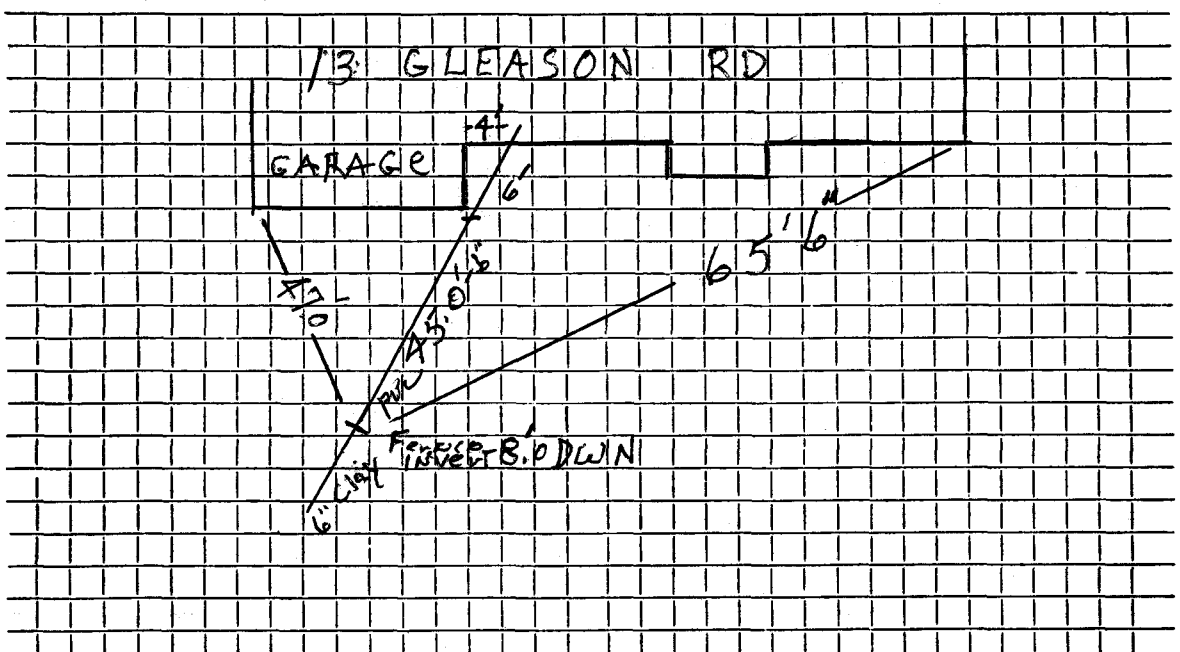

Connection made in ..... Street. Work completed 11/9/05 J. Melaghlin

Remarks: .....

.....

.....