Name Barry Couette **Service No.**

Address 17 GLEASON RD.

Location

Kind of Pipe PVC **Size** 4" & 6" **Size of Main**

Repair—Renewal—New Service McLaughlin #0590 **Location**

Date		Material	Amount		Total		Date			Amount	
8-7-	91	79.3 LF 6" PVC									
		6 LF 4" PVC									
		6"x6" WYE									
		2-4"x6" FERNCO'S									
		6" 45° BEND									

DATE _____

TOWN OF LEXINGTON — BOARD OF PUBLIC WORKS

SEWER DIVISION

Sketch of Service Here 17

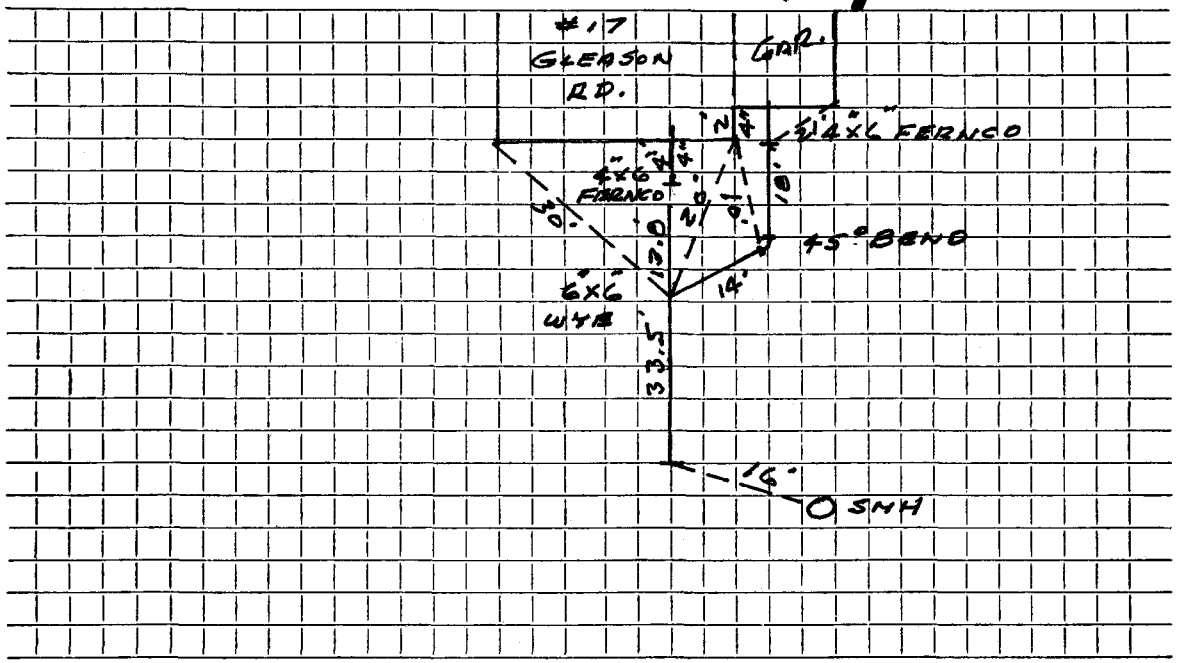

Connection made in GLEASON RD. Street. Work completed .....

Remarks: .....