Name Duffy Brothers **Service No.**

Address 4 Goffe Road

Location

Kind of Pipe **Size** **Size of Main**

Repair—Renewal—New Service Bonano #1102 #1180 **Location**

Date		Material	Amount	Total	Date			Amount
~~7/27/68~~	~~36'~~	~~6" Transite Pipe~~						
9/4/68	10'	4" Cast Iron						
	44'	6" Transite Pipe			7-27-68			
						36'	6" Transite	

H.B.M.18501

DATE _____

TOWN OF LEXINGTON — BOARD OF PUBLIC WORKS

SEWER DIVISION

Sketch of Service Here **4**

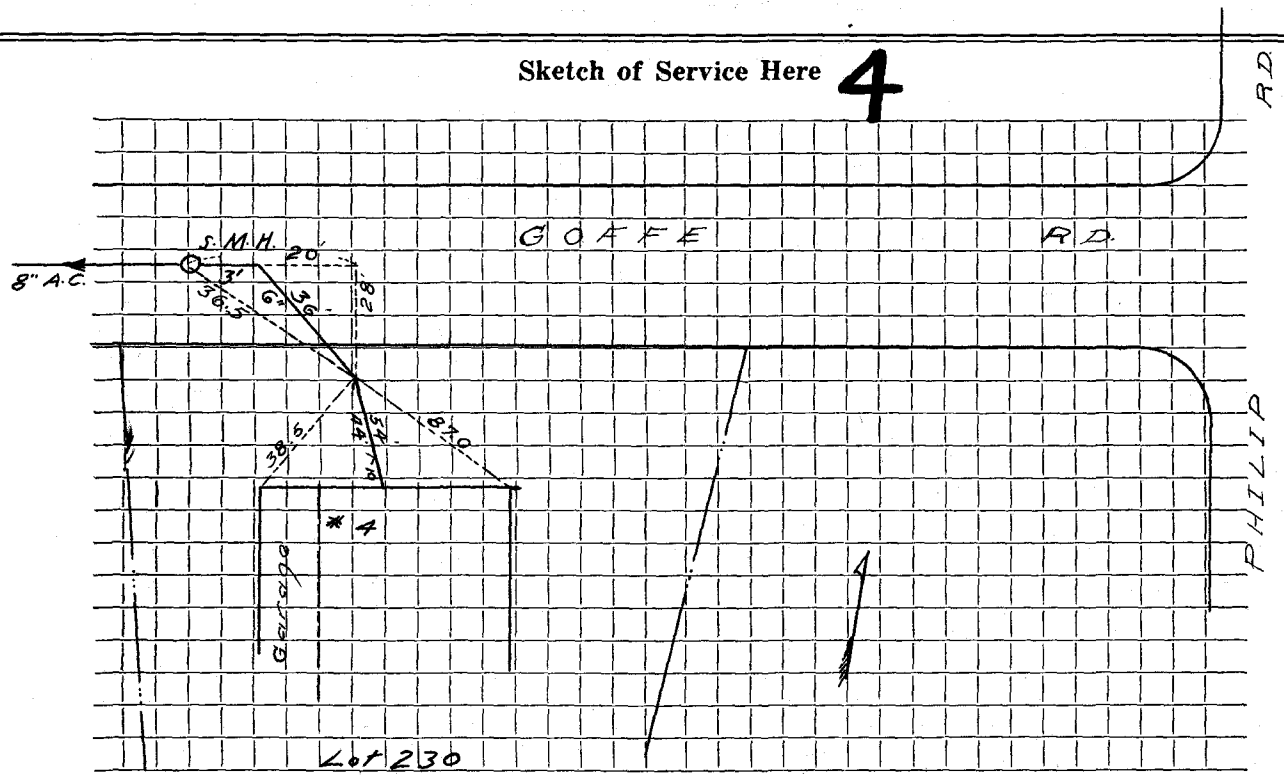

Connection made in ..... Street. Work completed .....

Remarks: .....

.....

.....