Name Richard Trzepacz **Service No.** 65

Address 7 Graham Road

Location

Kind of Pipe **Size** **Size of Main**

Repair—Renewal—New Service Valeri #2070 **Location** JUN 5 1972

Date		Material	Amount	Total	Date			Amount
~~Sep'68~~	~~24'~~	~~6" Transite pipe~~ @8	.00	192.00	5-15-72		Deposit	192 00
5-19-72	103'	6" Transite pipe						
	10'	4" Cast Iron pipe			9- -	68		
						24'	6" Transite	
					12-27-79		Roots in manhole across Property	
					5-12-81		Root in Manhole on property	

I.B.M.18501

#7

DATE _____

TOWN OF LEXINGTON — BOARD OF PUBLIC WORKS

SEWER DIVISION

Sketch of Service Here 7

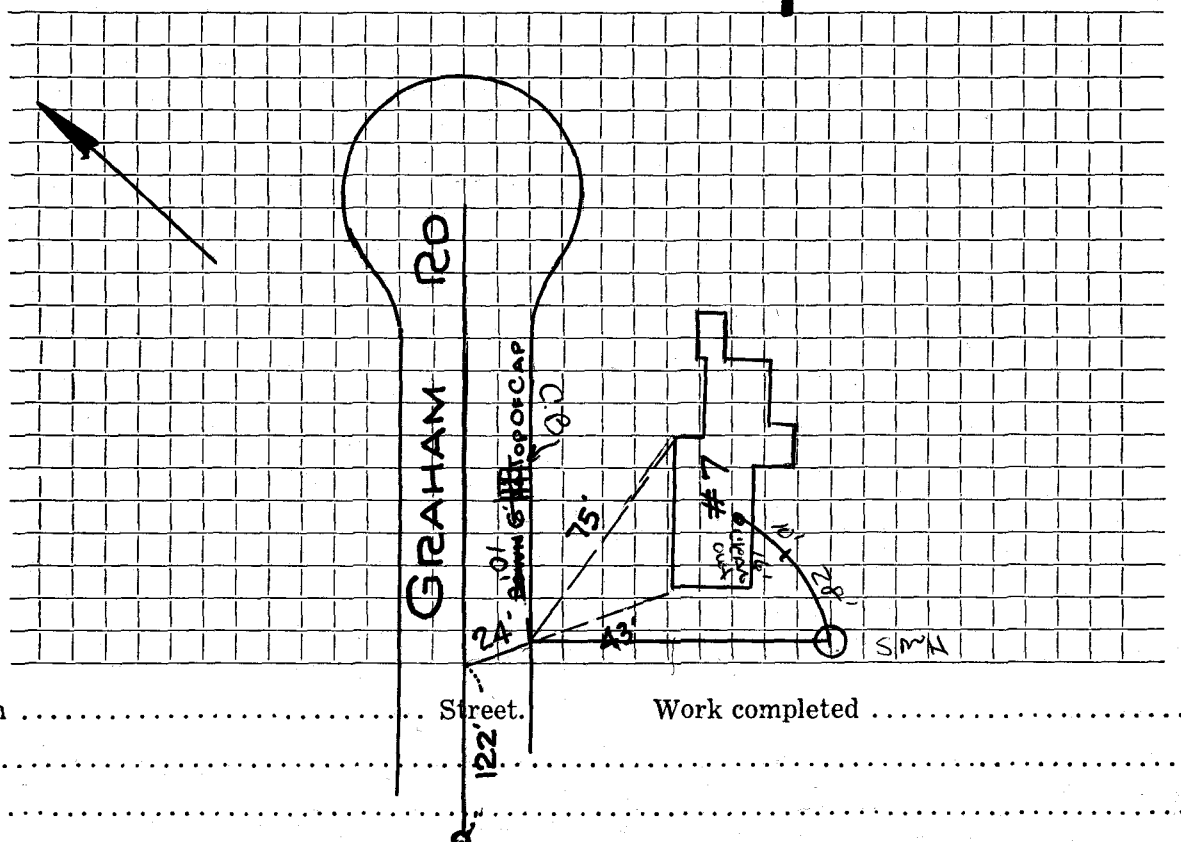

Connection made in ..... Street. Work completed .....

Remarks: .....

.....

.....