Name *Harlan Morrill* **Service No.** *28*

Address *8 Grant Place*

Location

Kind of Pipe **Size** **Size of Main**

~~Repair Renewal~~ **New Service** *Valeri #3995* **Location** OCT 21 1985

Date		Material	Amount		Total		Date			Amount	
~~8/3/83~~	~~5~~	~~L.F. 6" PVC~~			80	00	9-4-85		Deposit	80	00
9/10/85	83'	6" P.V.C.									
	2	6" Wye C.O.									
	1	6" x 3" Wye					8-3-83				
	1	1" x 3" Fernco						5'	6" P.V.C.		
	2	6" 45° Bends									

DATE _____

TOWN OF LEXINGTON — BOARD OF PUBLIC WORKS

SEWER DIVISION

Sketch of Service Here 8

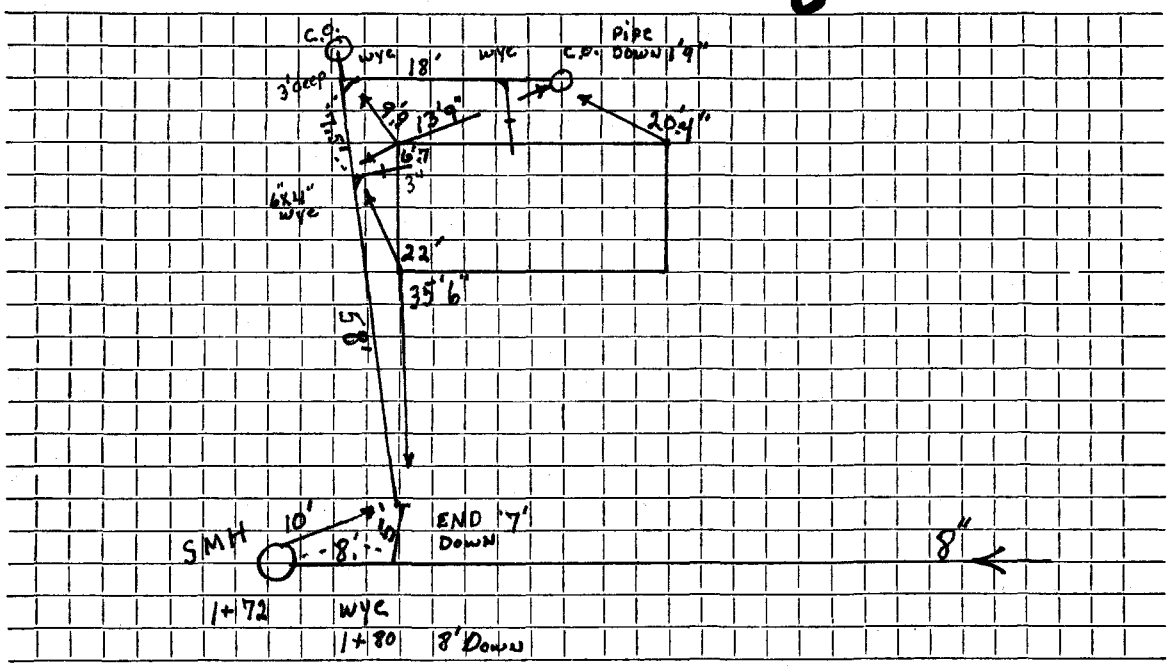

Connection made in GRANT PLACE Street. Work completed .....

Remarks: .....

.....

.....