Name Patricia Hanson **Service No.** 40

Address 100 Grant Street

Location

Kind of Pipe **Size** **Size of Main**

~~XXXXXXXXXXXXXXXX~~ New Service Valeri #3680 **Location** FEB 22 1982

Date		Material	Amount		Total		Date			Amount	
~~/7/80~~	~~30'~~	~~6" A.C.P.~~ @ $14.00			$420.	00	9-29-80		Deposit	420	00
.0/8/81	72'	6" P.V.C.									
	10'	4" Iron					6-7-	80			
	2	22° Bends						30'	6" A.C.P.		

DATE_____

TOWN OF LEXINGTON — BOARD OF PUBLIC WORKS

SEWER DIVISION

Sketch of Service Here 100

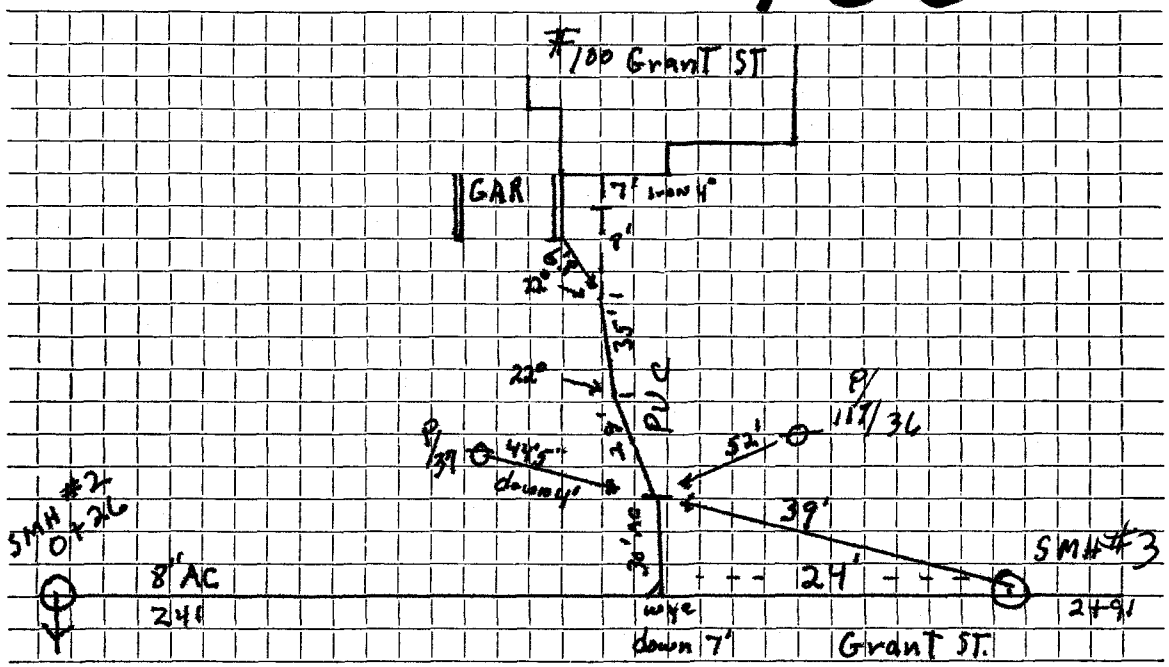

Connection made in ..... Street. Work completed .....

Remarks: .....

.....

....