Name

Service No.

Address 160 GRANT ST

Location

Kind of Pipe PVC

Size 6"

Size of Main 24"

Repair—Renewal—New Service

Location LOT 7

Date		Material	Amount	Total	Date		Amount
9/09	10'	4"-PVC					
	37'	6" PVC					
	1	4X6 Fernco					
	1	6" PVCXAC Fernco					
		EXIST IN-ST					
4/1/57	56'	TRANSITE					
		24" C.I. MAIN					

DATE _____

TOWN OF LEXINGTON — BOARD OF PUBLIC WORKS

SEWER DIVISION

Sketch of Service Here

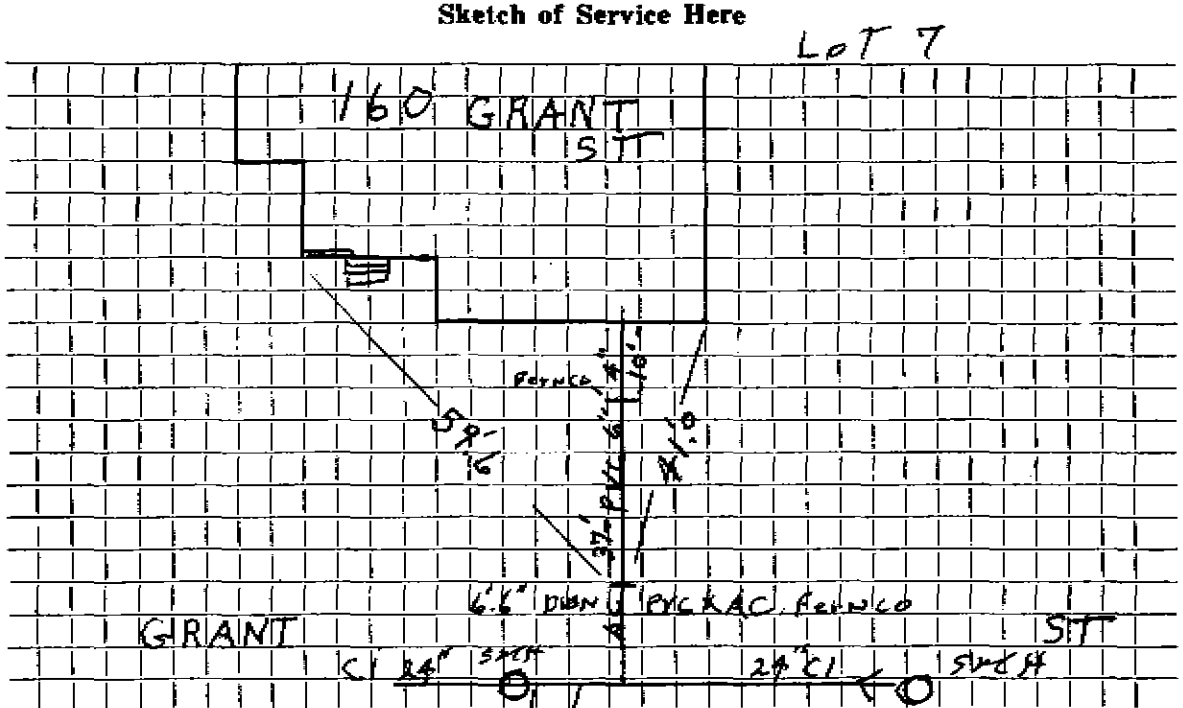

Connection made in ..... Street Todd RD Work completed 9/09

Remarks: Insp. W. Medber

.....

.....