Name **Service No.** 2358

Address 80 Grant ST

Location

Kind of Pipe **Size** **Size of Main**

Repair—Renewal—New Service J McLaughlin **Location**

Date		Material	Amount	Total	Date		Amount
12/28/06	6.0'	4" sch 40					
	61.0'	6" PVC					
	1	4&6 Ferrco					
9/27/05	25'	Exist PVC Stub					
	1'6"	Chimney					
	1-6"	90° Elbow					

DATE _____

TOWN OF LEXINGTON — BOARD OF PUBLIC WORKS

SEWER DIVISION

Sketch of Service Here

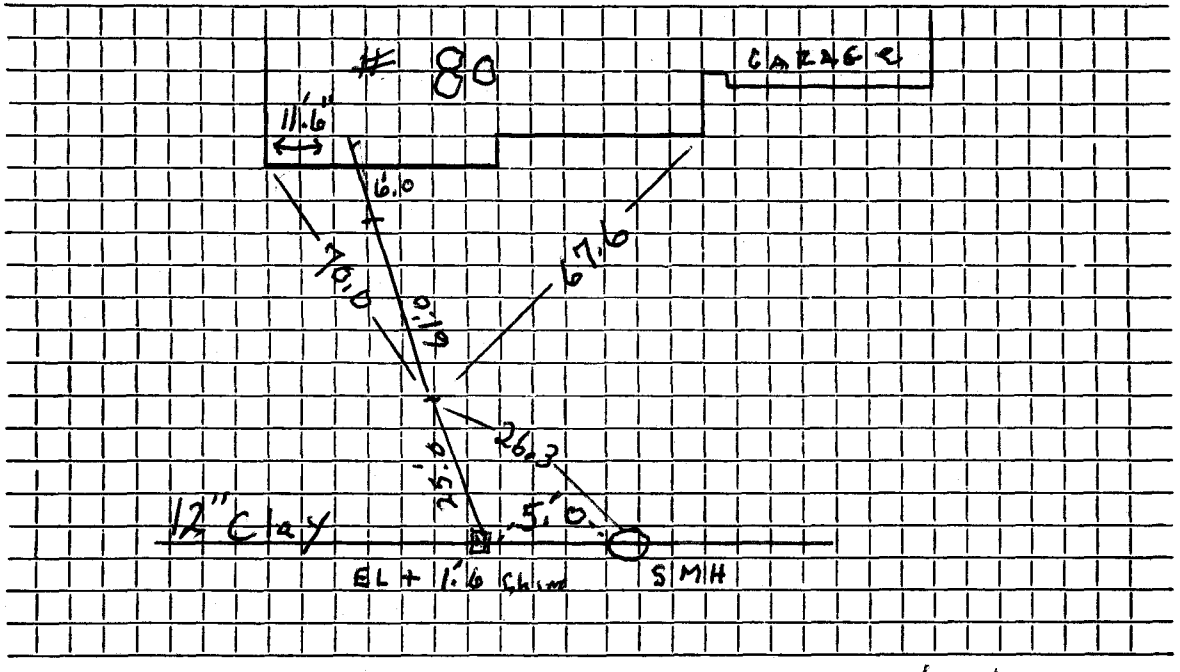

Connection made in Grant ST Street. Work completed 1/28/06 J. McLaughlin

Remarks: .....