Name Domenic Petrino **Service No.** 165

Address 14 Grape Vine Avenue

Lot #19 **Location**

Kind of Pipe **Size** **Size of Main**

~~Repairs~~ ~~Renewals~~ **New Service** COM. 12-31-54 **Location**

Date	Material	Amount	Total	Date		Amount
12/20/54	Labor	66 58		11-18-54	Deposited	175 00
12/27/54	"	47 36	113 94	12-31-54	Refunded	(49
	10% overhead		11 39			174 51
	86' - 6" sewer pipe @ .32		27 52			
	Joint compound		5 16			
	3 hrs. Town shovel @ 5.00		15 00			
	2 hrs. trucking @ .75		1 50			
			174.51			
	Labor					

TOWN OF LEXINGTON—DEPT. OF PUBLIC WORKS

SEWER DIVISION

DATE ..... NO. .....

The undersigned applies for the construction of a particular sewer connecting No. ..... Street and hereby agrees to comply with the Rules and Regulations governing the construction and use of Particular Sewers, as now or at any future time established by the Board of Selectmen.

Am't of estimate $.....

Am't Paid $.....

..... Owner

Sketch of Service Here

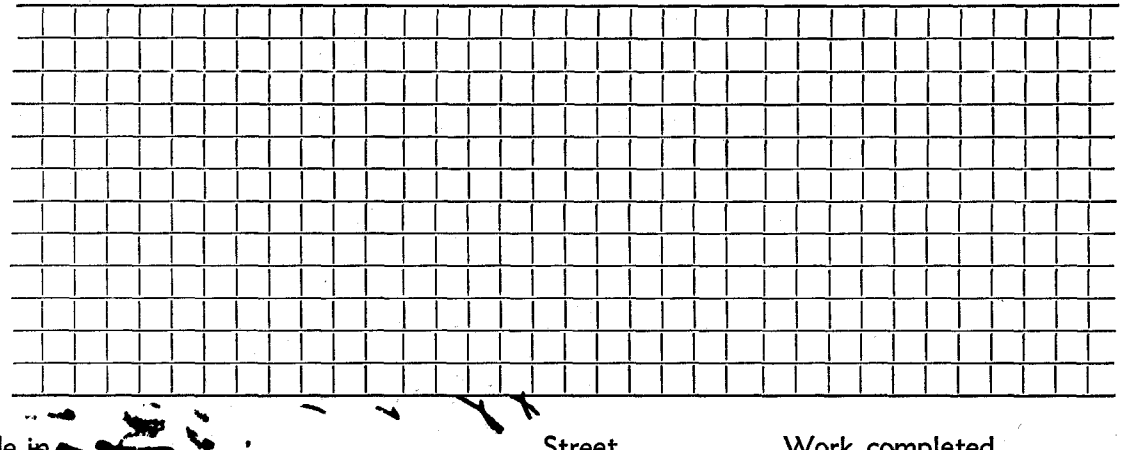

Connection made in ..... Street. Work completed ..... 19..

Remarks: