Name William Bitzer **Service No.** 41

Address 10 Grassland Street

Lot #209 **Location**

Kind of Pipe **Size** **Size of Main**

Repair—Renewal—New Service Valeri #570 **Location** JUL 24 1967

Date		Material	Amount		Total		Date			Amount	
~~Jul 166~~	~~18'~~	~~6" Transito pipe~~ @5	.00		90	.00	5-10-67		Deposit	90	00
5-10-67	24'	6" Transite pipe					7-	-66			
								18'	6" Transite		

H.B.M.18501

DATE _____

TOWN OF LEXINGTON — BOARD OF PUBLIC WORKS

SEWER DIVISION

Sketch of Service Here 10

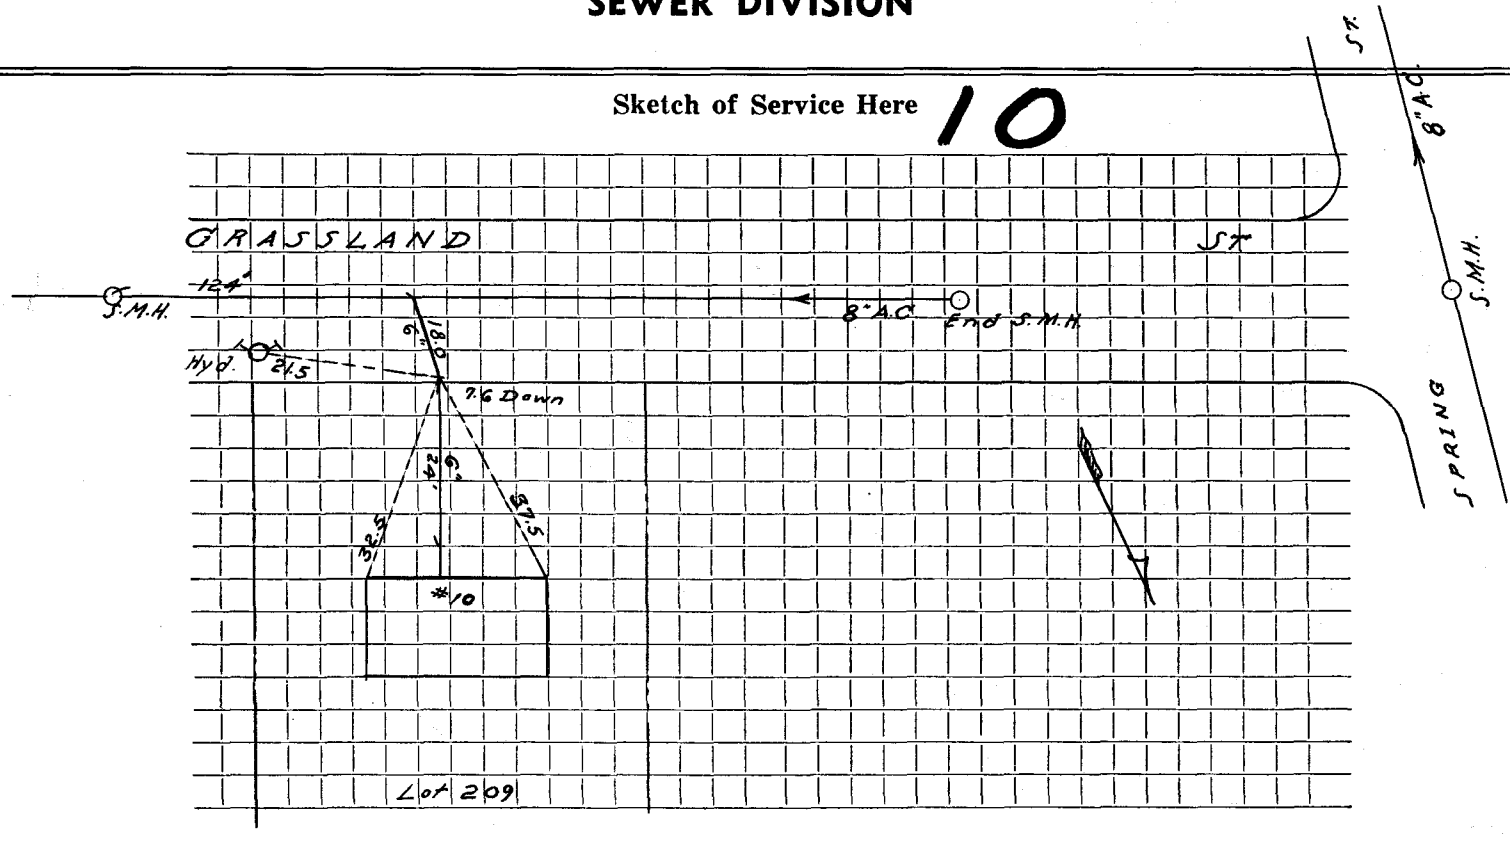

Connection made in ..... Street. Work completed .....

Remarks: .....

.....

.....