Name John E. McDonald **Service No.** 38

Address 17 Grassland Street

Lot 247 **Location**

Kind of Pipe **Size** **Size of Main**

Repair—Renewal—New Service Valeri Const. #566 **Location** JUL 24 1967

Date		Material	Amount	Total	Date		Amount
~~Jul '66~~	~~37'~~	~~6" Transite pipe~~ @5.00		185.00	5-8-67	Deposit	185 00
5/8/67	90'	6" Transite pipe					
	8'	4" Cast Iron Pipe			7- -66		
					37'	6" Transite	

H.B.M.18501

DATE_____

TOWN OF LEXINGTON — BOARD OF PUBLIC WORKS

SEWER DIVISION

Sketch of Service Here 17

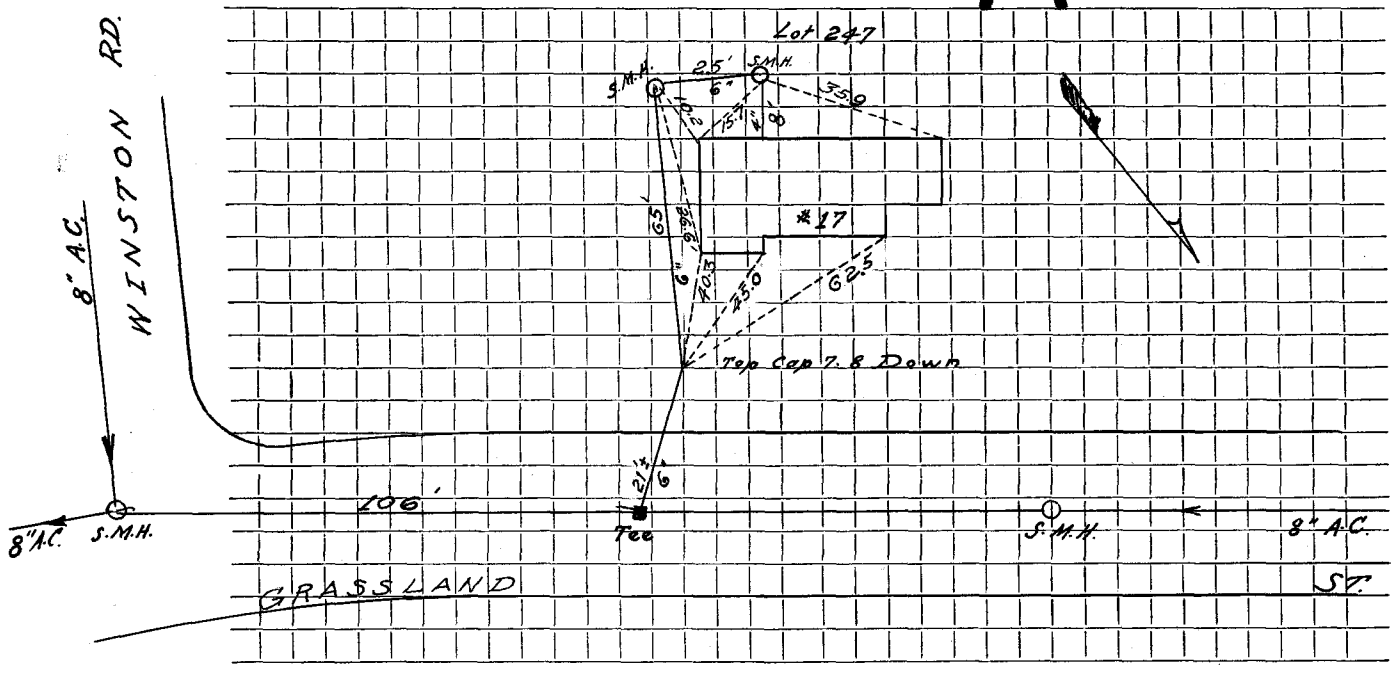

Connection made in ..... Street. Work completed .....

Remarks: .....

.....

.....