Name William Witthoft **Service No.** 31

Address 31 Grassland Street

Location

Kind of Pipe **Size** **Size of Main**

~~Repair~~ ~~Renewal~~ **New Service** Russell Sibley #2274 **Location** NOV 19 1973

Date		Material	Amount	Total	Date			Amount
~~1965~~	~~35'~~	~~6" Transite pipe~~ @7.00		245.00	4-24-73		Deposit	245.00
6/18/73	42'	6" Transite				65'		
	10'	4" Cast Iron				35'	6" Transite	

H.B.M.18501

DATE _____

TOWN OF LEXINGTON — BOARD OF PUBLIC WORKS

SEWER DIVISION

Sketch of Service Here

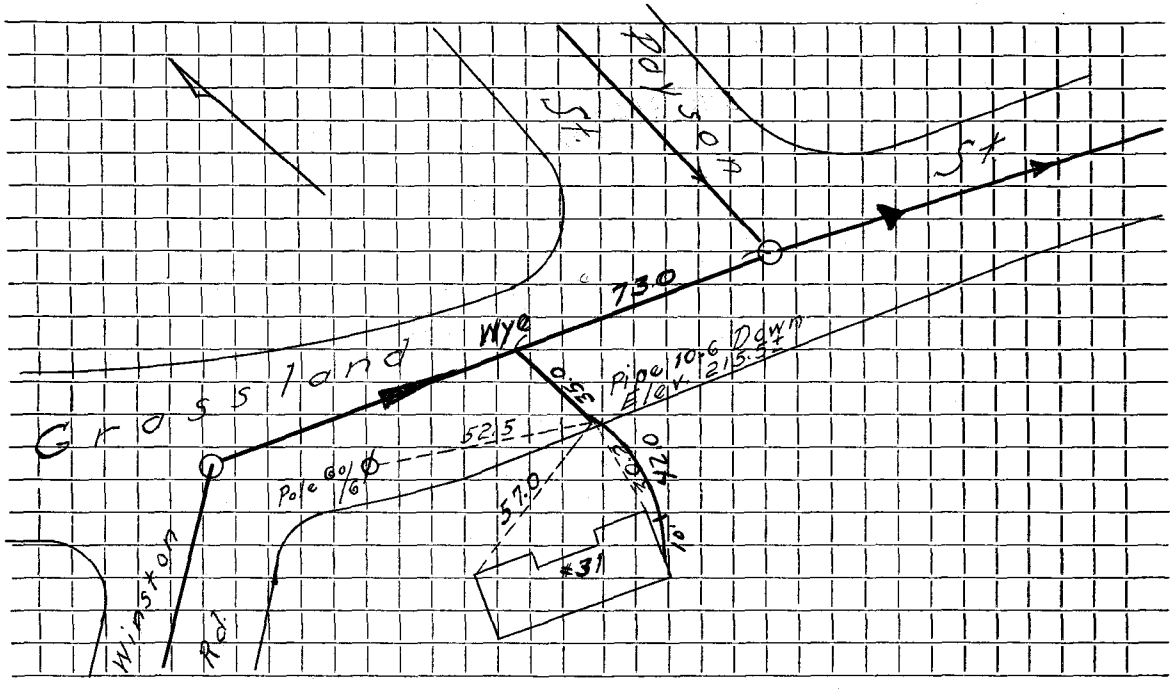

Connection made in ..... Street. Work completed .....

Remarks: .....

.....

.....