Name Donna Realty Trust **Service No.** 80

Address 68 Grassland St.

Location

Kind of Pipe **Size** **Size of Main**

~~Repair Renewal~~ **New Service** W.O. # 6713 Valeri #1433 **Location** SEP 2 1969

Date		Material	Amount		Total		Date			Amount	
8/15/69		Labor	106	48			8-5-69		Deposit	200	00
		10% O.H.	10	65	117	13	9-3-69		Refund	15	43
	25'	6" Transite pipe .88			22	00				184	57
		6" 90o Elbow			4	09					
	9½	Ton stone 1.65			14	85					
	3	Hrs. Shovel 6.50			19	50					
	2	" Trucking 1.50			3	00					
	4	" Pump 1.00			4	00					
					184	57					
8-21-69	27'	6" Transite pipe									

H.B.M.18501

DATE _____

TOWN OF LEXINGTON — BOARD OF PUBLIC WORKS

SEWER DIVISION

Sketch of Service Here 68

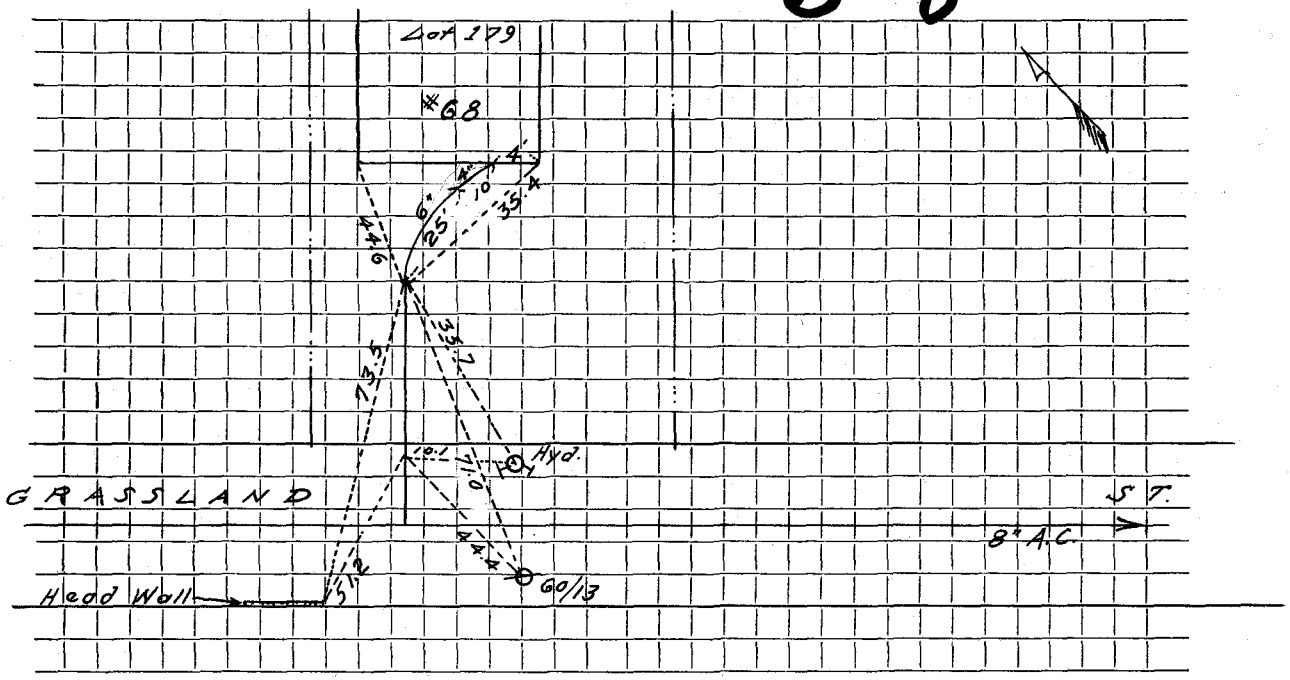

Connection made in ..... Street. Work completed .....

Remarks: .....

.....

.....