PEK 2/7/89

Name *Oscar Cormier* **Service No.**

Address 45 GROVE ST

Location

Kind of Pipe PVC **Size** 6" **Size of Main** 8"

Repair—Renewal—New Service *Oscar Cormier #4786* **Location**

Date	Material	Amount	Total	Date		Amount
~~6/67~~	~~22' of 6" TRANSITE PIPE~~ @ $7.00		154.00	6-22-89	Paid	154.00
11/88	39' of 6" PVC					
	FERNCO	NOTE:	WATER FOR 45 GROVE ST			
	~~3' CHIMNEY~~		OFF		TIDD CIRCLE	
			6- -67			
				22'	6" Transite	
				3'	Chimney	

DATE _____

TOWN OF LEXINGTON — BOARD OF PUBLIC WORKS

SEWER DIVISION

Sketch of Service Here 45

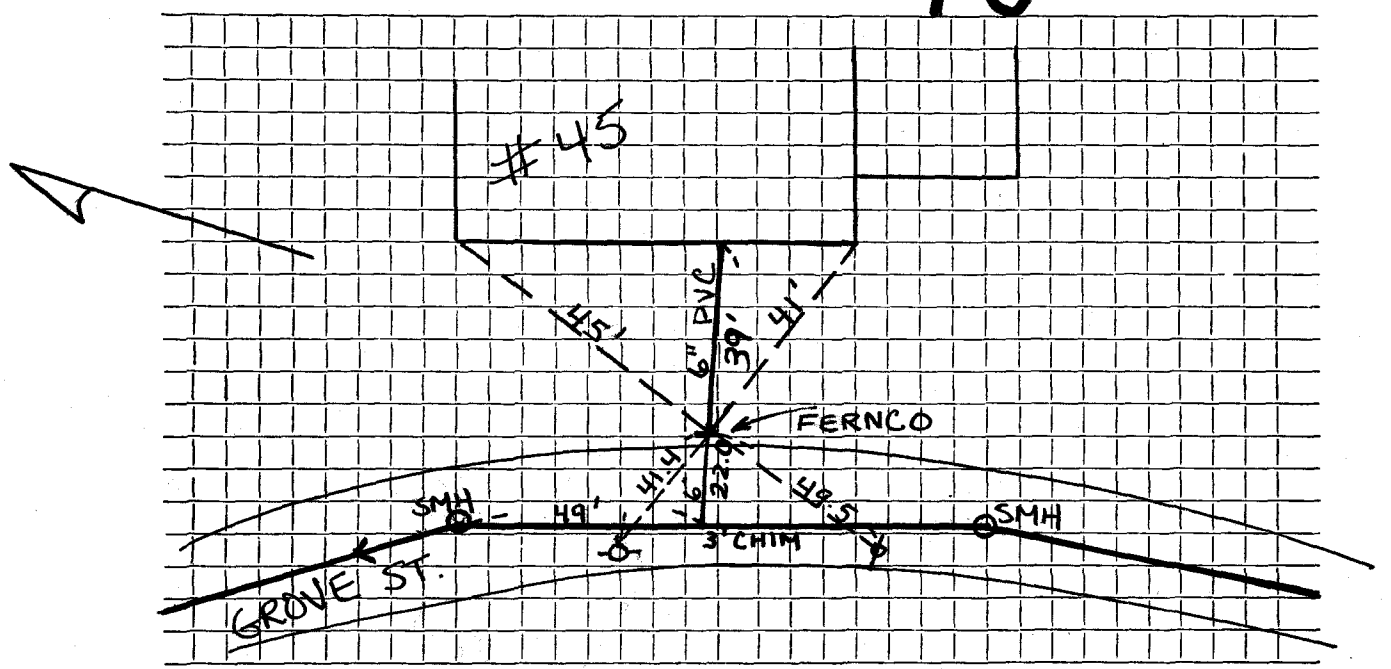

Connection made in Grove Street Street. Work completed .....

Remarks: .....

.....

.....