Name Harold Wilson **Service No.**

Address 6 Hadley Road

Lot #418 **Location**

Kind of Pipe **Size** **Size of Main**

Repair—Renewal—New Service DeFlice #829 **Location**

Date		Material	Amount		Total		Date			Amount	
10-17-67	42'	6" Transite pipe									
	10'	4" Cast Iron pipe									
							8-25'	65			
								36'	6" Transite		

H.B.M.18501

DATE _____

TOWN OF LEXINGTON — BOARD OF PUBLIC WORKS

SEWER DIVISION

Sketch of Service Here 6

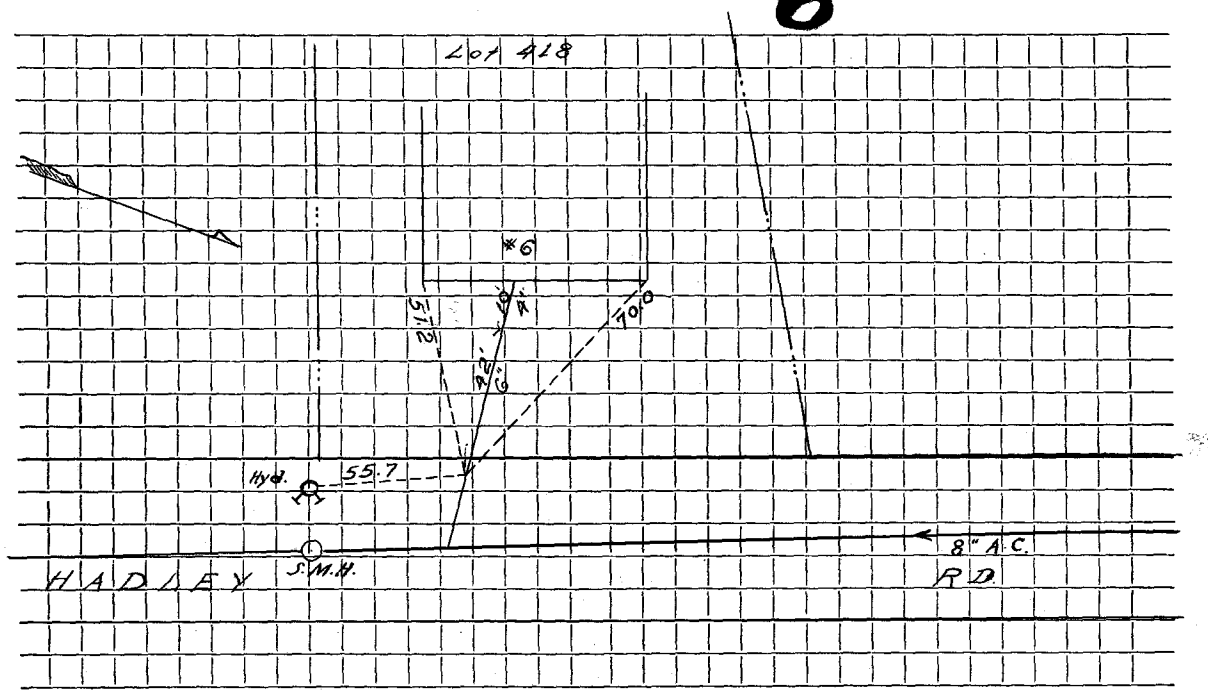

Connection made in ..... Street. Work completed .....

Remarks: .....

.....

.....