Name **Service No.**

Address 48 Hancock Street

Location

Kind of Pipe **Size** **Size of Main**

~~Replace~~—Renewal—~~New Service~~ **Location**

Date	Material	Amount	Total	Date			Amount
				RENEWAL		OUTSIDE #1103	
				4/1/80		Labor	
					1	6" x 5½' Transite pipe	
					3	6" x 5' Transite Nipple	
1/25/90	Respond & Measure				1	6" Fernco Adapter	
4/24/90	Homeowners responsibility				12	Brick	
					½	bag Cement	
					10	ton Gravel	
					8	hrs. Trucking	
					4	hrs. Town Shovel	
					2	hrs. Loader	

DATE _____

TOWN OF LEXINGTON — BOARD OF PUBLIC WORKS

SEWER DIVISION

Sketch of Service Here 48

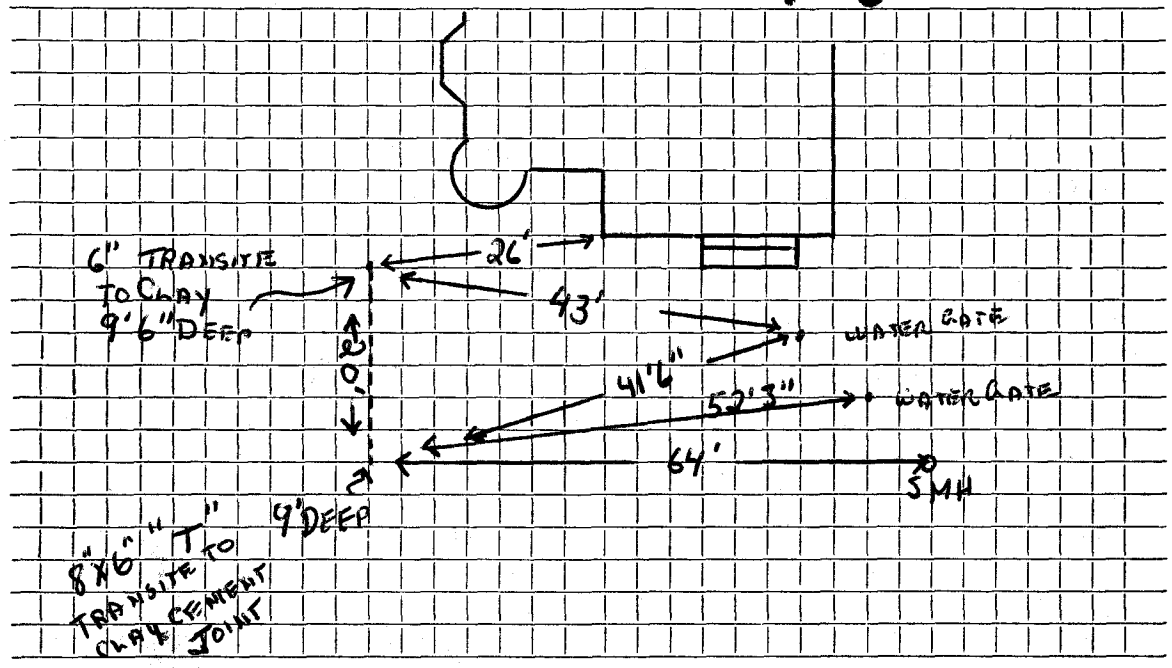

Connection made in ..... Street. Work completed .....

Remarks: Original Service 1927 .....

.....

.....