Name

Service No.

Address #56 HANCOCK ST.

Location

Kind of Pipe AC

Size

Size of Main

~~Repair~~ Renewal ~~New Service~~

Location

Date	Material	Amount	Total	Date			Amount
4/26/79	27'of 6" ACP	N.C.					
						OUTISDE W.O. #0435	
				5/15/79		Labor	
					2	6" X 10' Trans	
					2	6" X 5' Nipple	
					1	4" X 6" Donut	
					1	Hr. Trucking	

DATE _____

TOWN OF LEXINGTON — BOARD OF PUBLIC WORKS

SEWER DIVISION

Sketch of Service Here 56

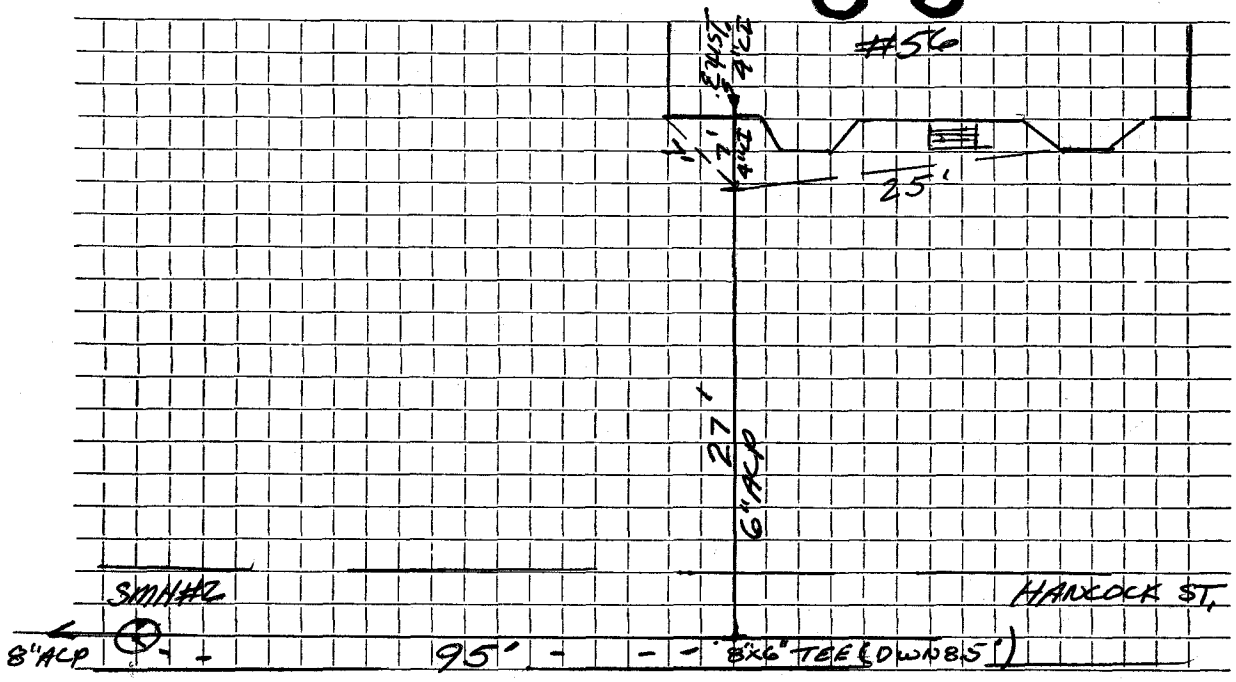

Connection made in ..... HANCOCK ..... Street. · Work completed .....

Remarks: Renewal done by TOWN Public Works

Original Service 1927