Name **Service No.**

Address 78~~8~~ Hancock Street

~~Lot B~~ **Location**

Kind of Pipe **Size** **Size of Main**

Repair—Renewal—New Service Redmond #4570 **Location**

Date		Material	Amount	Total	Date			Amount
~~7/12/86~~	~~37'~~	~~6" P.V.C.~~						
	~~1~~	~~6" 90° Elbow~~						
	~~1'~~	~~Chim~~			7-12-	86		
	~~1~~	~~Service Saddle~~				37'	6" P.V.C.	
		Redmond #4608				1	6"- 90° Elbow	
10/28/86	12.5'	6" P.V.C.				1	Service Saddle	
	6'	4" P.V.C.				1	1' Chimney	
		4 x 6 Fernoc						

DATE _____

TOWN OF LEXINGTON — BOARD OF PUBLIC WORKS

SEWER DIVISION

Sketch of Service Here 78

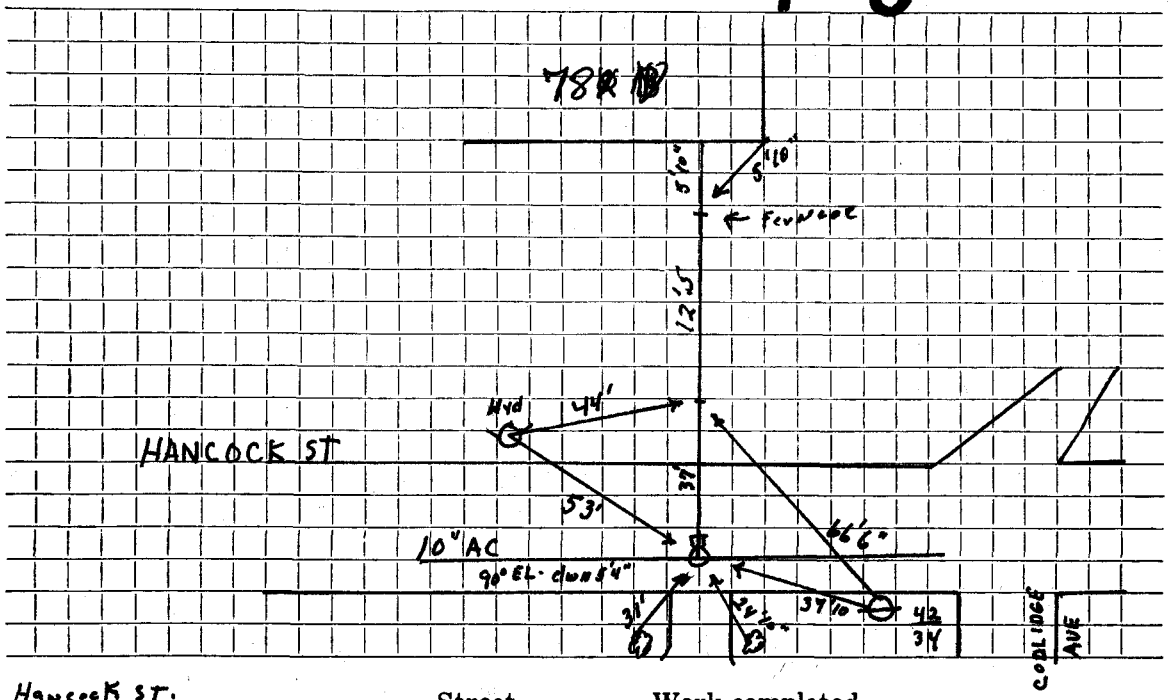

Connection made in Hancock ST. Street. Work completed .....

Remarks: 5'4" Top of Elbow ledge 6' down