Name **Service No.**

Address 90 Hancock St. (Swimming Pool in Rear)

Location

Kind of Pipe AC **Size** **Size of Main**

~~Repair~~—**Renewal**—~~**New Service**~~ D&F TRUCKING PERMIT NO. 3357 **Location**

Date	Material	Amount	Total	Date		Amount
11/16/78	91'-6" ACP					
	10'-4" CI					

DATE _____

TOWN OF LEXINGTON — BOARD OF PUBLIC WORKS

SEWER DIVISION

Sketch of Service Here 90

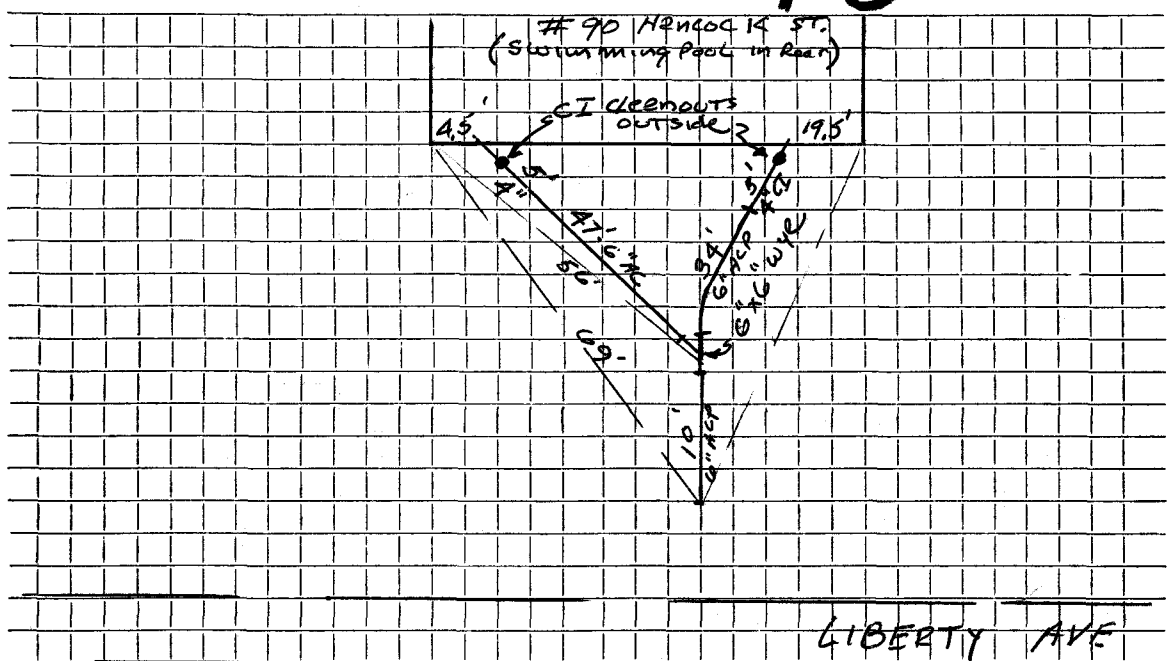

Connection made in ..... Street. Work completed .....

Remarks: Original Service 4-1-54