Name A. Purney Acker **Service No.** 38

Address 27 Hayes Lane

Location

Kind of Pipe 6" AC **Size** 6" **Size of Main** 8"

Repair—Renewal—New Service ✓ Lex. Sewerage # 2509 **Location** FEB 10 1975

Date	Material	Amount	Total	Date		Amount
6-18-74	21' AC @ 9.00	$189.00		6-19-74	Deposit	189 00
6-19-74	20' 4" CI					
	82' 6" AC					

B.M.18501

DATE _____

TOWN OF LEXINGTON — BOARD OF PUBLIC WORKS

SEWER DIVISION

Sketch of Service Here 27

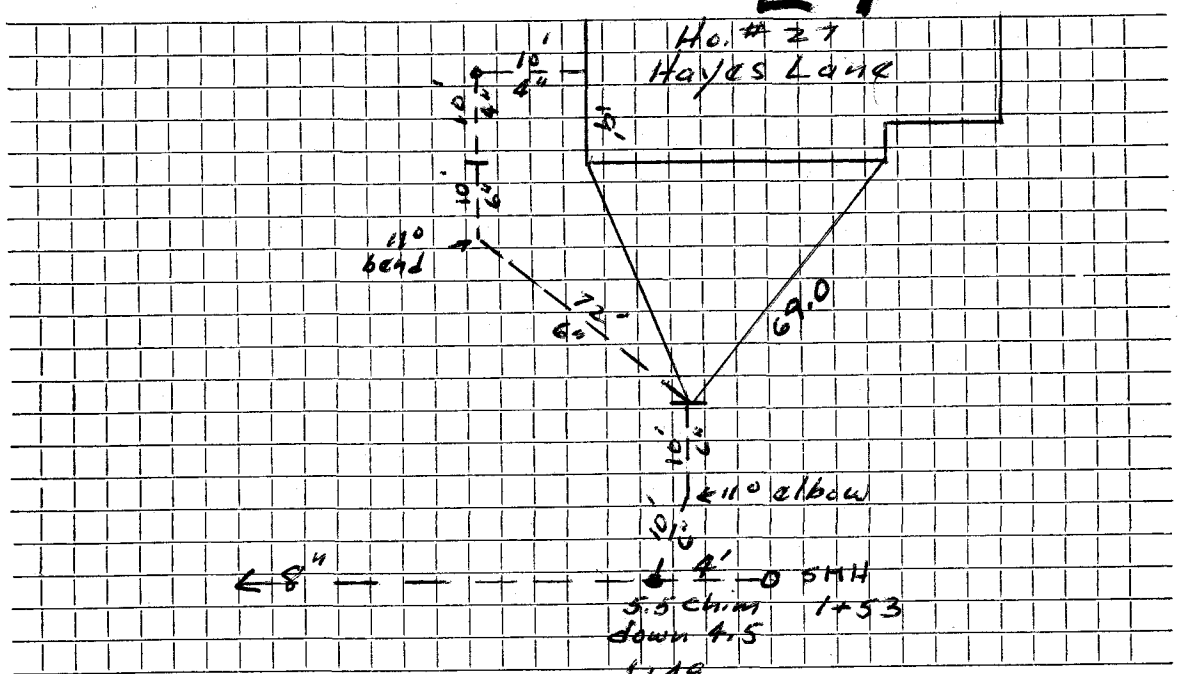

Connection made in Hayes Lane Street. Work completed .....

Remarks: .....

.....

.....