Name Peter D. Engels **Service No.** 33

Address 21 HAYWARD AVE

Location

Kind of Pipe PVC **Size** 6" **Size of Main** 8"

~~Repair~~ ~~Renewal~~ **New Service** NEW SERVICE Valeri #3720 **Location** SEP 21 1981

Date		Material	Amount		Total		Date			Amount	
~~Nov 20, 1980~~		~~28' of 6" PVC~~	14	00	392	00	8-28-81		Deposit	392	00
9/11/81	75'	P.V.C. pipe									
	10'	A.C.					11-20-80				
								28'	6" P.V.C.		

DATE Nov. 20, 1980

TOWN OF LEXINGTON — BOARD OF PUBLIC WORKS

SEWER DIVISION

Sketch of Service Here 21

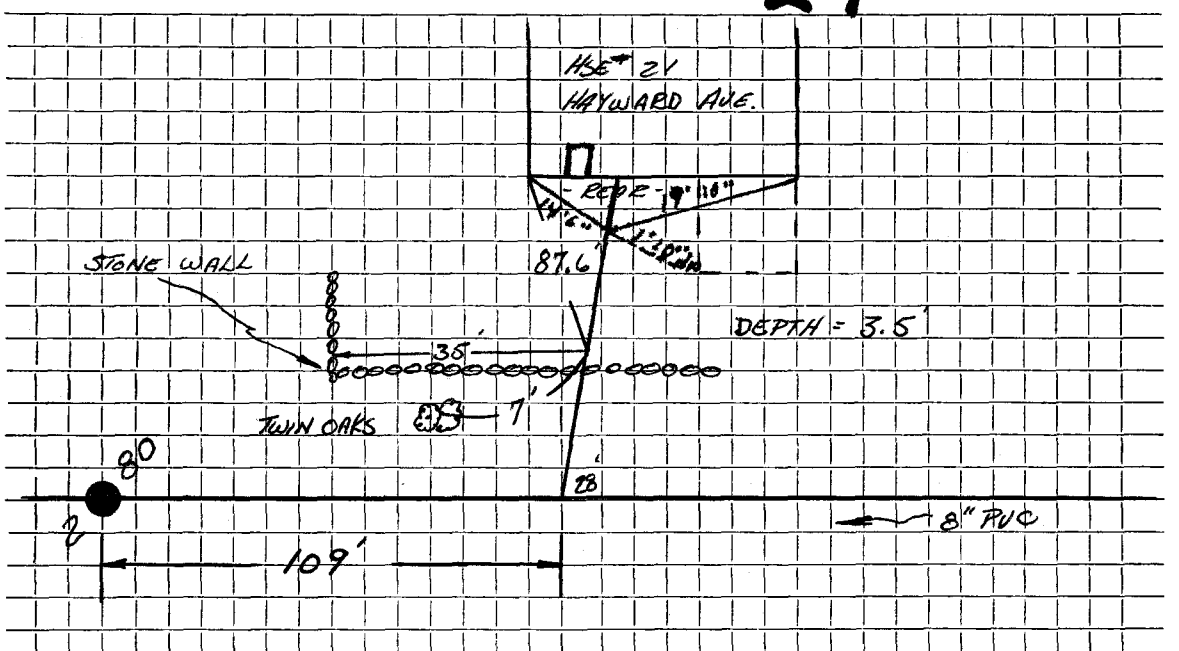

Connection made in SUNSET Street. Work completed Nov. 20, 1980

Remarks: