**Name** Kirkland Nelson **Service No.**

**Address** 27 Hayward Avenue

**Location**

**Kind of Pipe** PVC **Size** 6" **Size of Main**

**Repair—Renewal—New Service** Kirkland & Shaw #0549 **Location**

| Date | | Material | Amount | | Total | | Date | | | Amount | |
|---|---|---|---|---|---|---|---|---|---|---|---|
| ~~12/1/80~~ | ~~20'~~ | ~~6" PVC @ $14.00~~ | | | $280 | .00 | 9-4-90 | | Paid | 280 | 00 |
| 9/4/90 | 36' | 6" PVC | | | | | | | | | |
| | 1' | 4" PVC | | | | | | | | | |
| | | 6" x 4" Reducer (Fernco) | | | | | 12-1- | 80 | | | |
| | 3 | 45° Couplings | | | | | | 20' | 6" P.V.C. | | |
| | | 22° Couplings | | | | | | | | | |

DATE 9/4/90

TOWN OF LEXINGTON — BOARD OF PUBLIC WORKS

# SEWER DIVISION

Sketch of Service Here 27

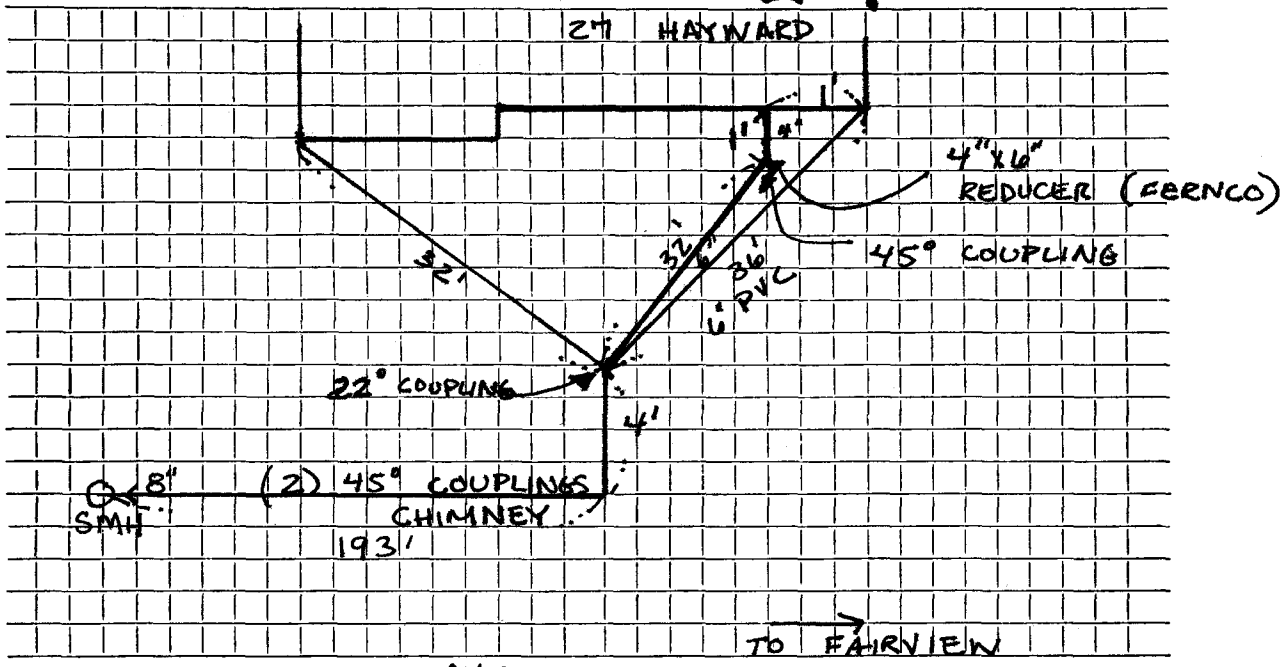


Connection made in HAYWARD ~~Street~~ AVE. Work completed

Remarks: INSPECTOR: P. A. BARROWS

CONTRACTOR: KIRKLAND & SHAW