Name Ralph Hall **Service No.**

Address 17 Heritage Drive

Lot #16 **Location**

Kind of Pipe **Size** **Size of Main**

~~Repair~~ * ~~Renewal~~ * **New Service** ~~DeFlice #1697~~ John Melone & Sons, Cont. Permit #1151 **Location**

Date		Material	Amount		Total		Date			Amount	
~~8/2/68~~	~~31'~~	~~6" Transite pipe~~									
8-7-70	75'	6" Transite pipe									
	10'	4" Cast Iron pipe					8-2-	68			
								31'	6" Transite		
								1	6"X8" Wye		

H.B.M.18501

DATE _____

TOWN OF LEXINGTON — BOARD OF PUBLIC WORKS

SEWER DIVISION

Sketch of Service Here 17

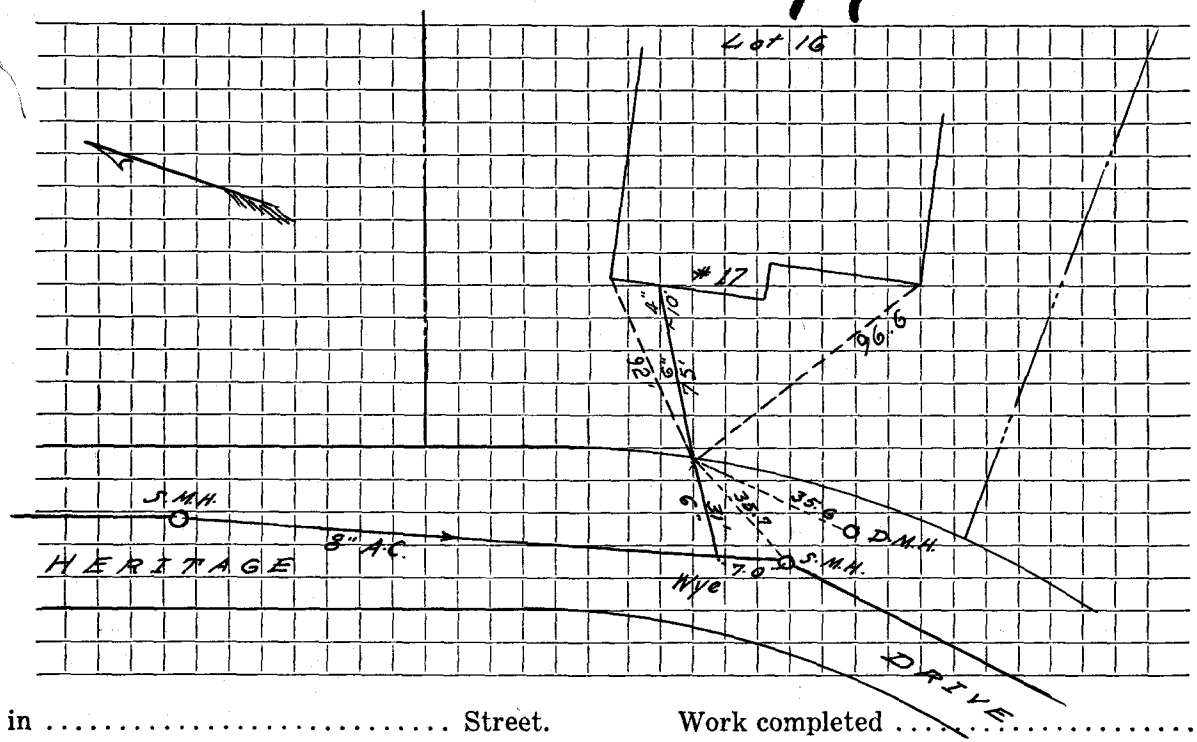

Connection made in ..... Street. Work completed .....

Remarks: .....

.....

.....