Name Ralph Hall **Service No.**

Address 20 Heritage Drive
Lot #21 **Location**

Kind of Pipe **Size** **Size of Main**

~~Repair~~ ~~Renewal~~ **New Service** ~~DeFelice # 2045~~ John Melone & Sons, Cont. Permit #1148 **Location**

Date		Material	Amount	Total	Date			Amount
~~8/2/68~~	~~31'~~	~~6" Transite pipe~~						
5/1/72	64'	6" Transite pipe						
	10'	4" Cast Iron			8-2-	68		
						31'	6" Transite	
						1	6"X 8" Wye	

H.B.M.18501

DATE _____

TOWN OF LEXINGTON — BOARD OF PUBLIC WORKS

SEWER DIVISION

Sketch of Service Here 20

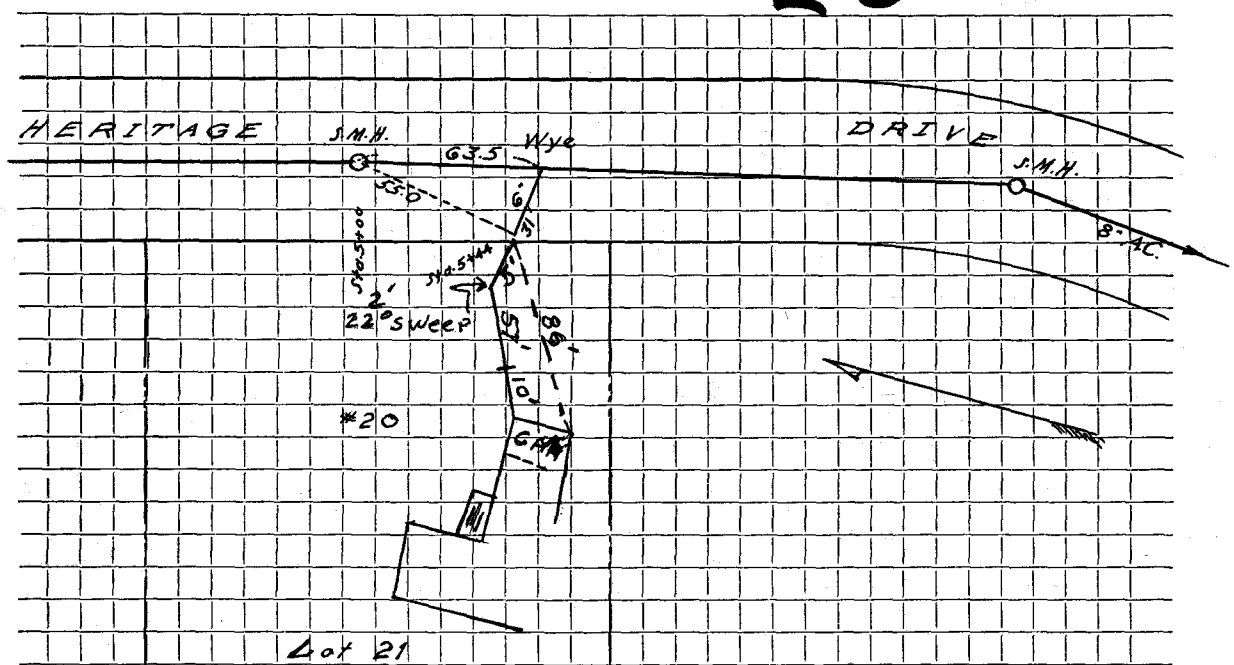

Connection made in ..... Street. Work completed .....

Remarks: .....

.....

.....