Name Hall & Co. **Service No.**

Address 21 Heritage Drive

Location

Kind of Pipe **Size** **Size of Main**

Repair—Renewal—New Service DeFelice Bros. #1529 **Location**

Date		Material	Amount	Total	Date			Amount
1-19-70	78'	6" Transite Pipe						
	10'	4" Cast Iron Pipe						
					8-2-68			
						30.6'	6" Transite	
						1	6" X 8" Wye	

H.B.M.18501

DATE _____

TOWN OF LEXINGTON — BOARD OF PUBLIC WORKS

SEWER DIVISION

Sketch of Service Here 21

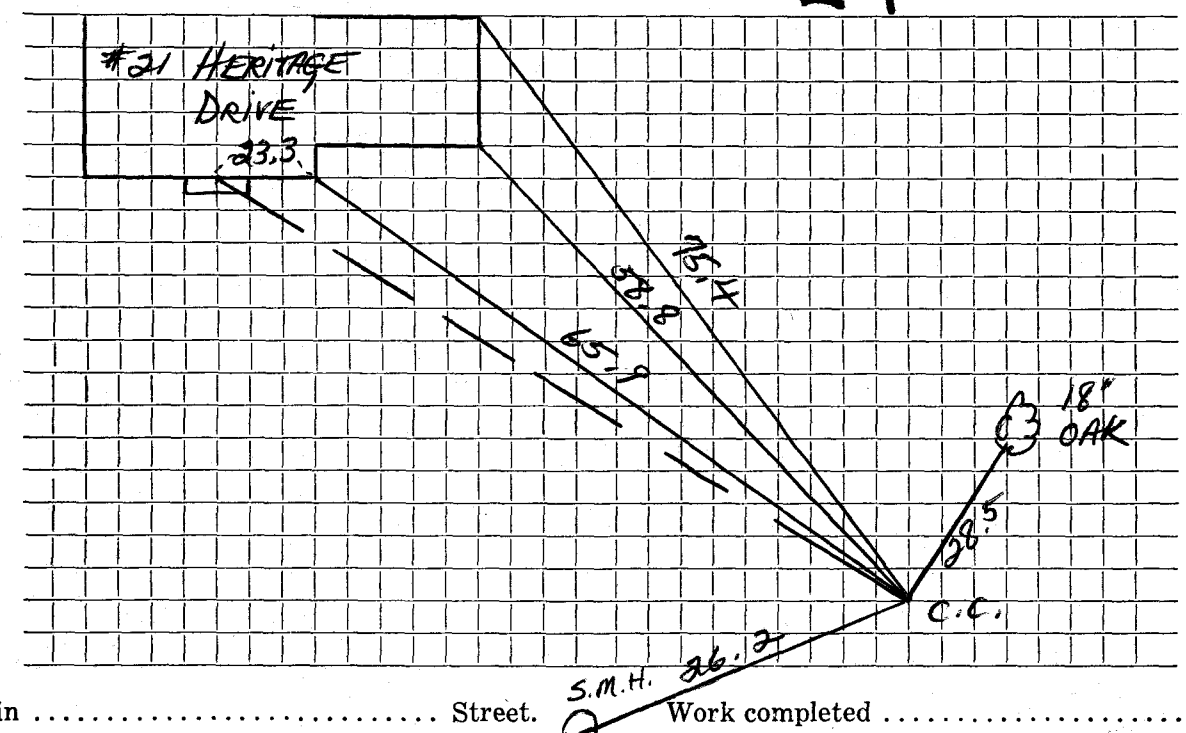

Connection made in ..... Street. Work completed .....

Remarks: .....

.....

.....