Name S & A Realty **Service No.**

Address 7 Heritage Drive

Location

Kind of Pipe **Size** **Size of Main**

Repair—Renewal—New Service DeFelice Bros. #1577 **Location**

Date		Material	Amount		Total		Date			Amount	
5-8-70	38'	6" Transite Pipe									
	10'	4" Cast Iron Pipe									
							8-2-	68			
								31'	6" Transite		
								1	6"X 8" Wye		

H.B.M.18501

DATE _____

TOWN OF LEXINGTON — BOARD OF PUBLIC WORKS

SEWER DIVISION

Sketch of Service Here 7

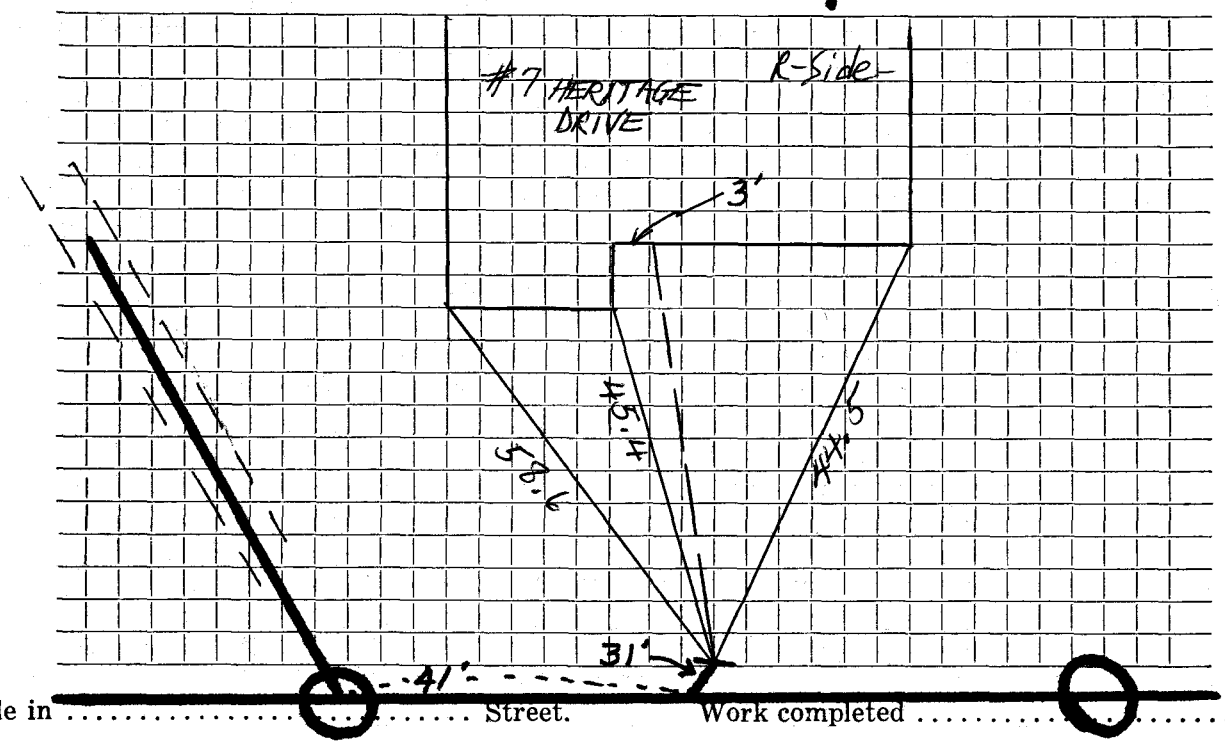

Connection made in ..... Street. Work completed .....

Remarks: .....

.....

.....