Name Ralph Hall **Service No.**

Address 9 Heritage Drive

Lot #13 **Location**

Kind of Pipe DeFlice permit #2077 **Size** **Size of Main**

~~Repair~~ ~~Renewal~~ **New Service** John Melone & Sons/ Cont. Permit #1154 **Location**

Date		Material	Amount	Total	Date			Amount
~~8/2/68~~	~~30'~~	~~6" Transite pipe~~						
6/20/72	170'	6" Transite			8-2-	68		
	10'	4" Cast Iron				30'	6" Transite	
						1	6" X 8" Wye	

H.B.M.18501

DATE _____

TOWN OF LEXINGTON — BOARD OF PUBLIC WORKS

SEWER DIVISION

9 Sketch of Service Here

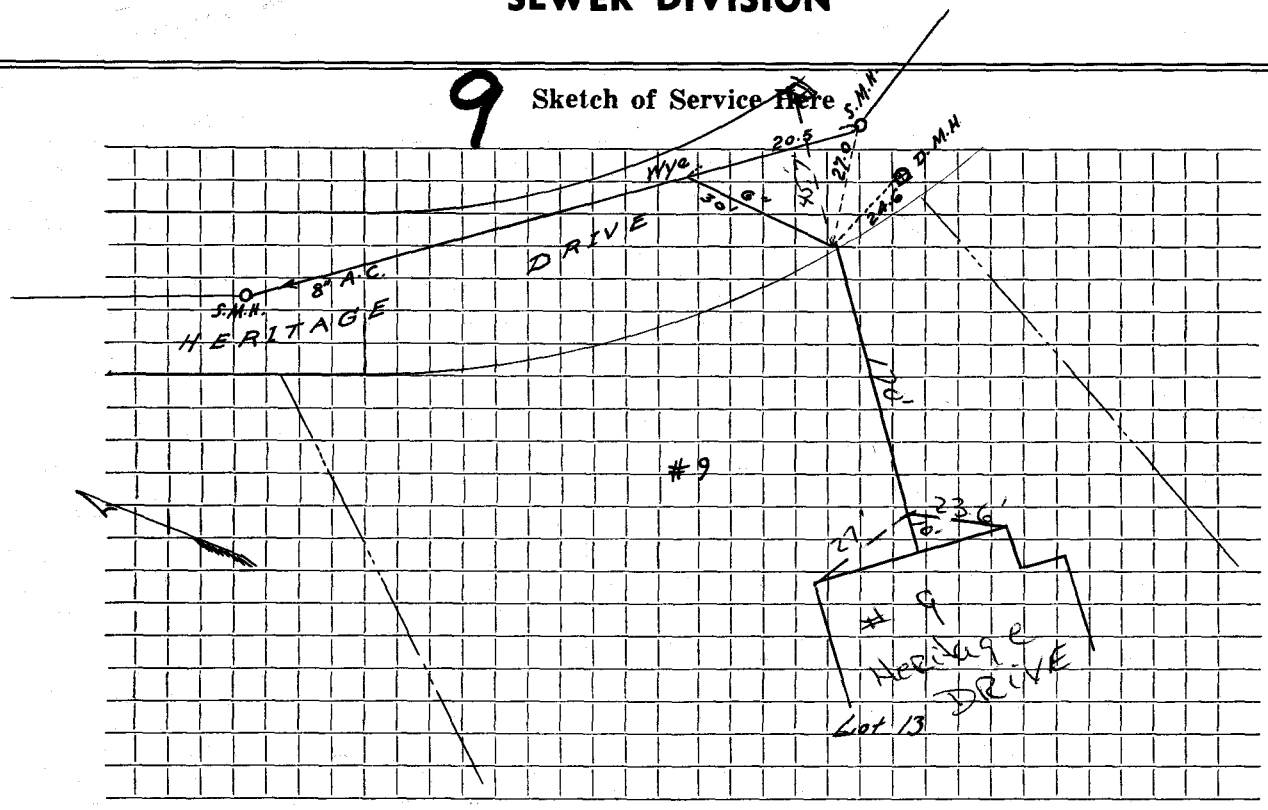

Connection made in ..... Street. Work completed .....

Remarks: .....

.....

.....