Name Alda Lawn **Service No.** 229

Address 2226 Mass. Avenue

2226 Mass. Ave. **Location** Committed 4-2-56

Kind of Pipe **Size** **Size of Main**

~~Repair~~ ~~Renewal~~ **New Service** **Location**

Date	Material	Amount	Total	Date		Amount
1-16-56	Labor	67 69		12-5-55	Deposited	$200 00
	10% overhead	6 77	74 46	4-9-56	Paid by Refund	3 14
	60' - 6" Sewer pipe @ .50		30 00			203 14
	Joint compound		3 60			
	1 hr. trucking		75			
	9 1/3 hrs. Littlefield Shovel @ 8.50-79		33			
	15x3 patching		15 00			
			203 14			
	Labor					

HP-9694

TOWN OF LEXINGTON—DEPT. OF PUBLIC WORKS
SEWER DIVISION

DATE..... NO. .....

The undersigned applies for the construction of a particular sewer connecting No..... Street and hereby agrees to comply with the Rules and Regulations governing the construction and use of Particular Sewers, as now or at any future time established by the Board of Selectmen.

Am't of estimate $.....

Am't Paid $.....

..... Owner

Sketch of Service Here

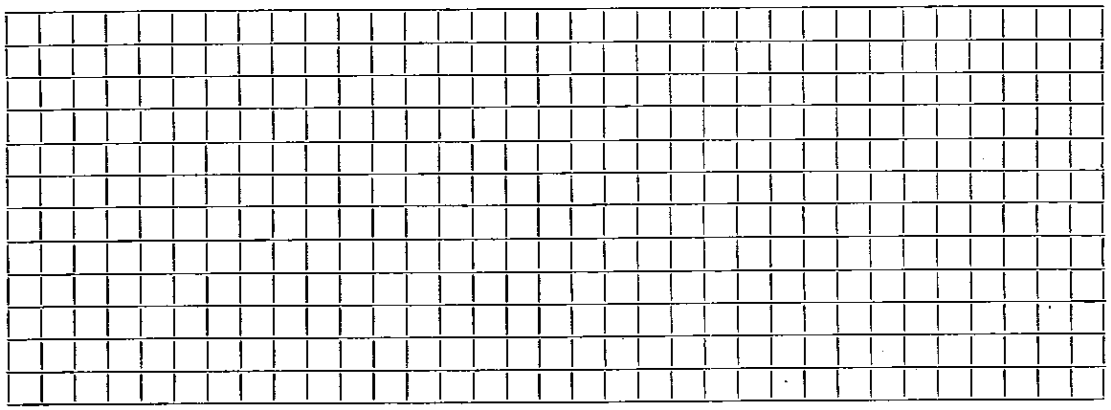

Connection made in..... Street. Work completed.....19..

Remarks: