Name

Service No.

Address ~~912~~ & 914 Mass. Ave.

Lexington 914 Mass. Ave. Location

Kind of Pipe

Size

Size of Main

Repair—~~[illegible]~~

Location

Date	Material	Amount	Total	Date		Amount
					NON CHARGE	
				9/18/52	Labor	38 23
					22' - 6" sewer pipe @.342	7 52
					1 - 6" elbow	1 88
					joint compound	1 32
					7 2/3 hrs. Littlefield shovel @.7	53 67
					2 hrs. trucking	1 50
					patching 22 x 3	22 00
						126 12
	Labor					
				9/20/48	Labor	

P-9694

TOWN OF LEXINGTON—DEPT. OF PUBLIC WORKS
SEWER DIVISION

DATE..... NO. .....

The undersigned applies for the construction of a particular sewer connecting No..... Street and hereby agrees to comply with the Rules and Regulations governing the construction and use of Particular Sewers, as now or at any future time established by the Board of Selectmen.

Am't of estimate $.....

Am't Paid $.....

..... Owner

Sketch of Service Here

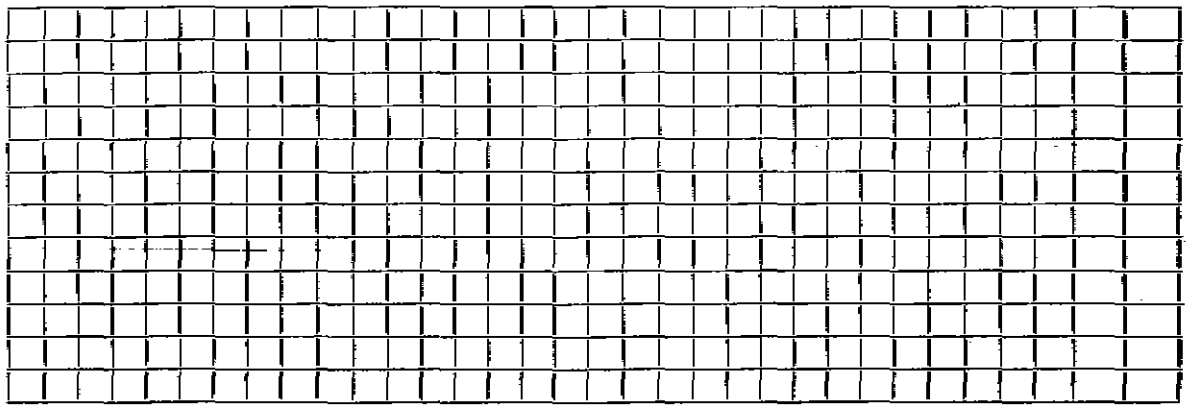

Connection made in..... Street. Work completed.....19..

Remarks: