Name Busa Bros. **Service No.** 17

Address 7 Melrose Avenue

7 Melrose Ave. **Location**

Kind of Pipe **Size** 6" **Size of Main** 8"

Repair—Renewal—New Service **Location** Comm 5-4-59

Date	Material	Amount		Total		Date		Amount	
4-15-59	Labor	67	41			4-9-59	Deposit	100	00
	10% O. H.	6	74	74	15	5-22-59	Paid	38	89
	50' 6" Transite Pipe @.70			35	00			138	89
	1 11¼° Transite Elbow			2	24				
	4 Hrs. Town Shovel @6.50			26	00				
	2 Hrs. Trucking @.75			1	50				
				138	89				
	Labor								
							Bill sent 5-4-59	38.89	

S.B.M.18501

TOWN OF LEXINGTON—DEPT. OF PUBLIC WORKS
SEWER DIVISION

DATE..... NO. .....

The undersigned applies for the construction of a particular sewer connecting No..... Street and hereby agrees to comply with the Rules and Regulations governing the construction and use of Particular Sewers, as now or at any future time established by the Board of Selectmen.

Am't of estimate $.....

Am't Paid $.....

..... Owner

Sketch of Service Here

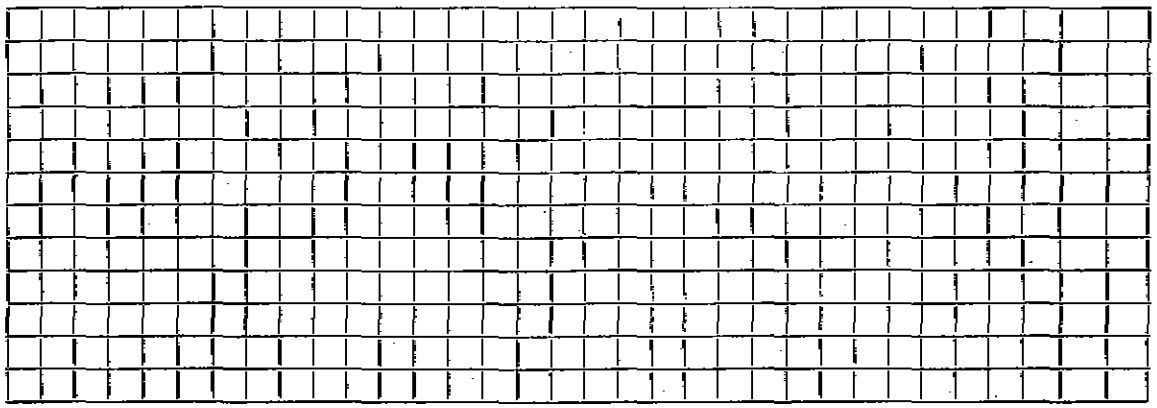

Connection made in..... Street. Work completed.....19..

Remarks: