Name Leeland Const. Co. **Service No.** 183

Address 21 Merriam Street

Lexington, Mass. **Location** 21 Meriam ST.

Kind of Pipe **Size** **Size of Main**

~~Repair~~ ~~Renewal~~ **New Service** com. 12-31-51 **Location**

Date	Material	Amount	Total	Date		Amount
1/30/51	Labor	25 65		10-30-51	Deposited	150 00
	10% overhead	2 59	28 22	12-31-51	Refunded	27 90
	56' - 6" sewer pipe @ .342		19 15		Credited to bal	(9 99
	1 - 6" elbow		1 88		due on #123 1950	
	joint compound		3 36	Plumbers	OWNER RODDED OUT + TINKERED WITH	
	6 hrs. Littlefield shovel @ 7.00		42 00	10/23/96	Problem MAYBE 48" OUT	
	2 hrs. trucking		1 50		RESPOND + MESURE JW	
	patching 16 x 3		16 00			
			112 11			
	Labor					

TOWN OF LEXINGTON—DEPT. OF PUBLIC WORKS

SEWER DIVISION

DATE ..... NO. .....

The undersigned applies for the construction of a particular sewer connecting No. ..... Street and hereby agrees to comply with the Rules and Regulations governing the construction **and** use of **Particular** Sewers, as now or at any future time established by the Board of Selectmen.

Am't of estimate $.....

Am't Paid $.....

..... Owner

Sketch of Service Here

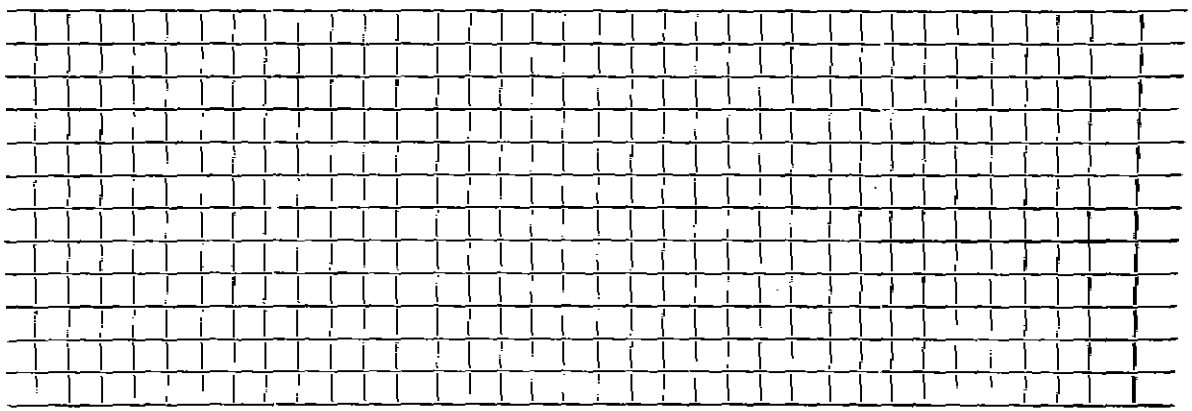

Connection made in ..... Street. Work completed ..... 19..

Remarks: