Name **Service No.**

Address 35 Merriam St

Location

Kind of Pipe **Size** **Size of Main**

Repair—Renewal—New Service **Location**

Date	Material	Amount	Total	Date		Amount
6-4-02	4X6 CI to PVC Fernco					
	21'-5"—6" PVC					

DATE _____

TOWN OF LEXINGTON — BOARD OF PUBLIC WORKS

SEWER DIVISION

Sketch of Service Here

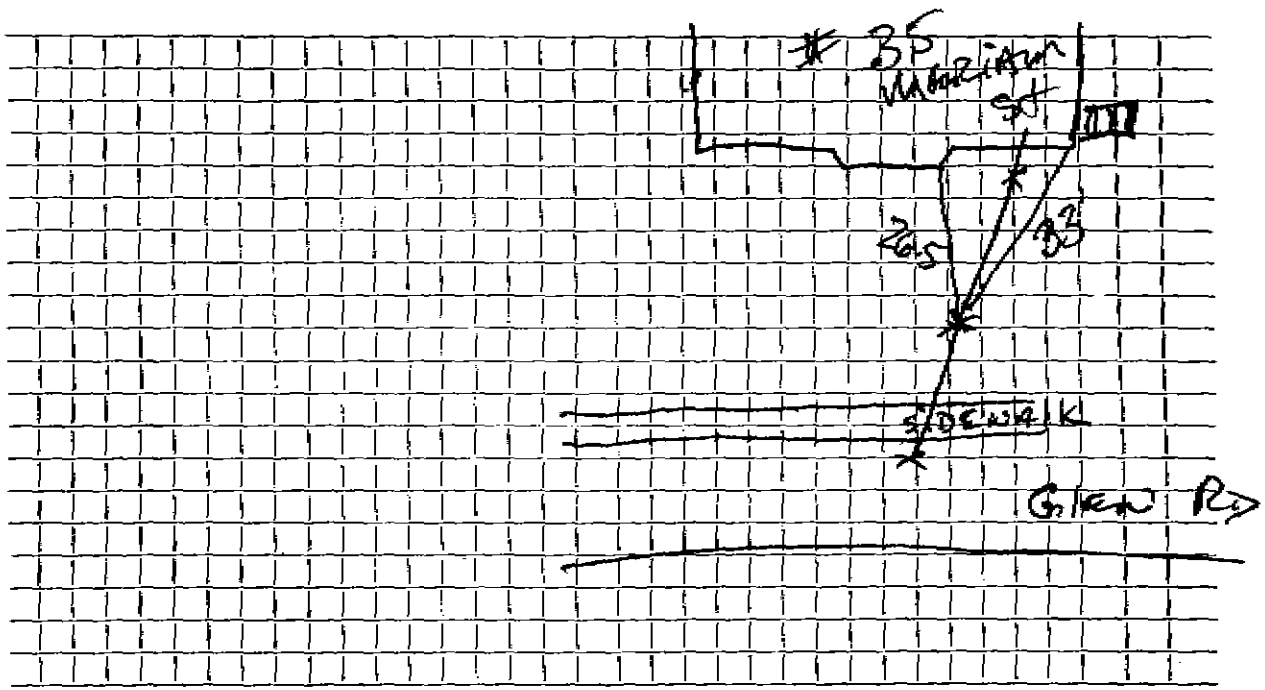

Connection made in ..... Street. Work completed .....

Remarks: INSIDE RENEWED - TOWN MADE A REPAIR from Edge of Road to back of SIDEWALK