Name E. Conrad Levy **Service No.** 31

Address 68 Meriam Street

68 Meriam ST. **Location** Lot 1288

Kind of Pipe **Size** **Size of Main**

Repair—Renewal—New Service Eagle #1599 **Location** JUL 27 1970

Date		Material	Amount	Total	Date		Amount
69	26'	8" Transite pipe @10.00= $260.00		130.00	5-19-71	Deposit	130.00
		COST TO BE SPLIT WITH #66					
-20-70	26'	6" Transite pipe					
	5'	4" Cast Iron pipe					
	100'	8" Transite pipe (split with #66)					

M.18501

DATE _____

TOWN OF LEXINGTON — BOARD OF PUBLIC WORKS

SEWER DIVISION

Sketch of Service Here **68**

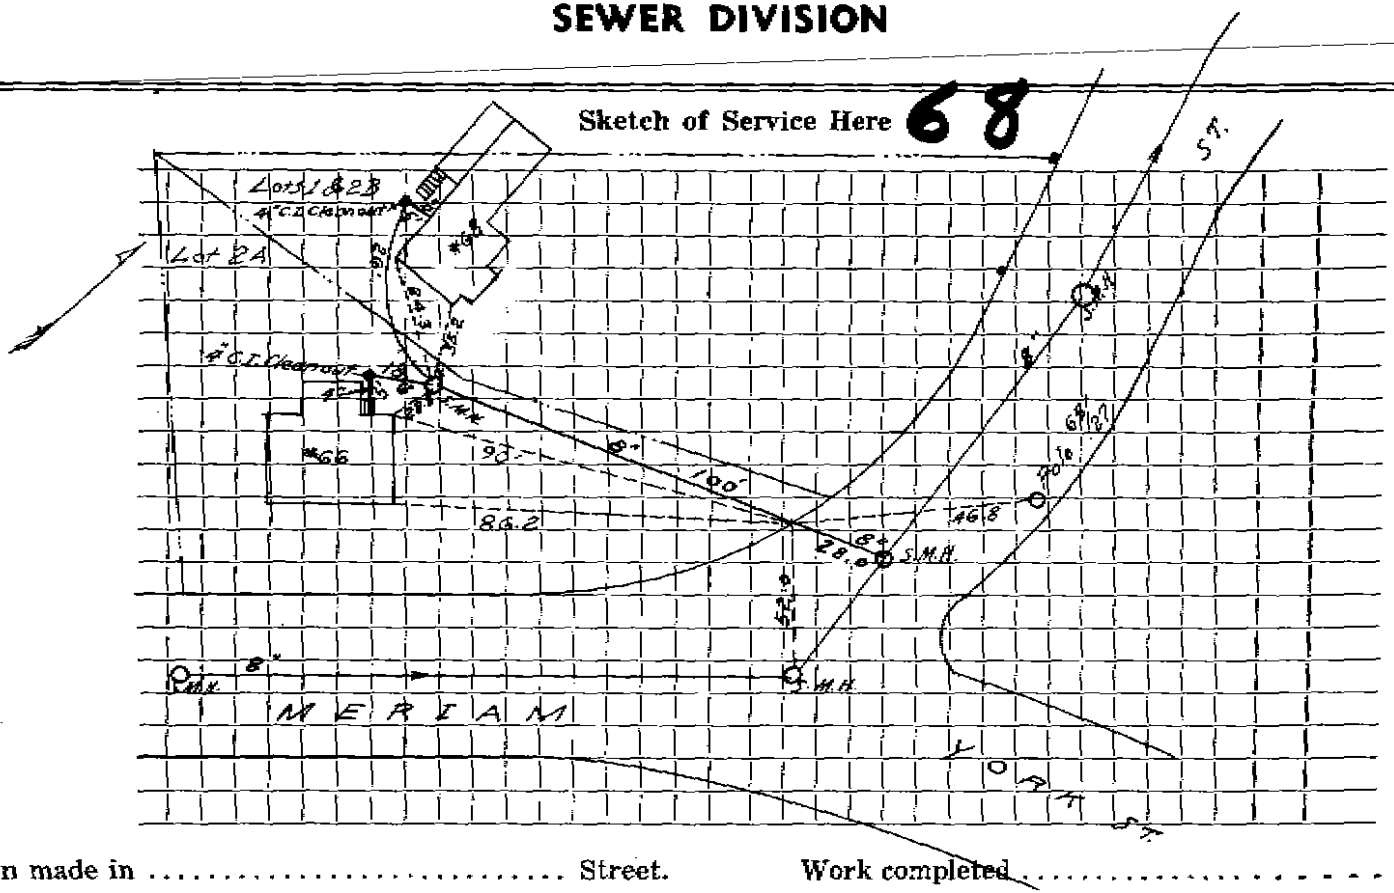

Connection made in ..... Street. Work completed .....

Remarks: .....

.....

.....