Name Ruth H. Wilson **Service No.** 88

Address 73 Meriam Street

Lots Pt. 37 & 36 **Location** 73 Meriam ST.

Kind of Pipe **Size** 6" **Size of Main** 8"

~~Repair~~ ~~Renewal~~ **New Service** Eagle #1934 **Location** AUG 14 1972

Date		Material	Amount		Total		Date			Amount	
~~1969~~	~~26.5'~~	~~6" Transite Pipe~~	@ 10.00		270	00	10-22-71		Deposit	270	00
								'69'			
								26.5'	6" Transite		
								1	6" X 8" Wye		

W.18501

DATE _____

TOWN OF LEXINGTON — BOARD OF PUBLIC WORKS

SEWER DIVISION

Sketch of Service Here 73

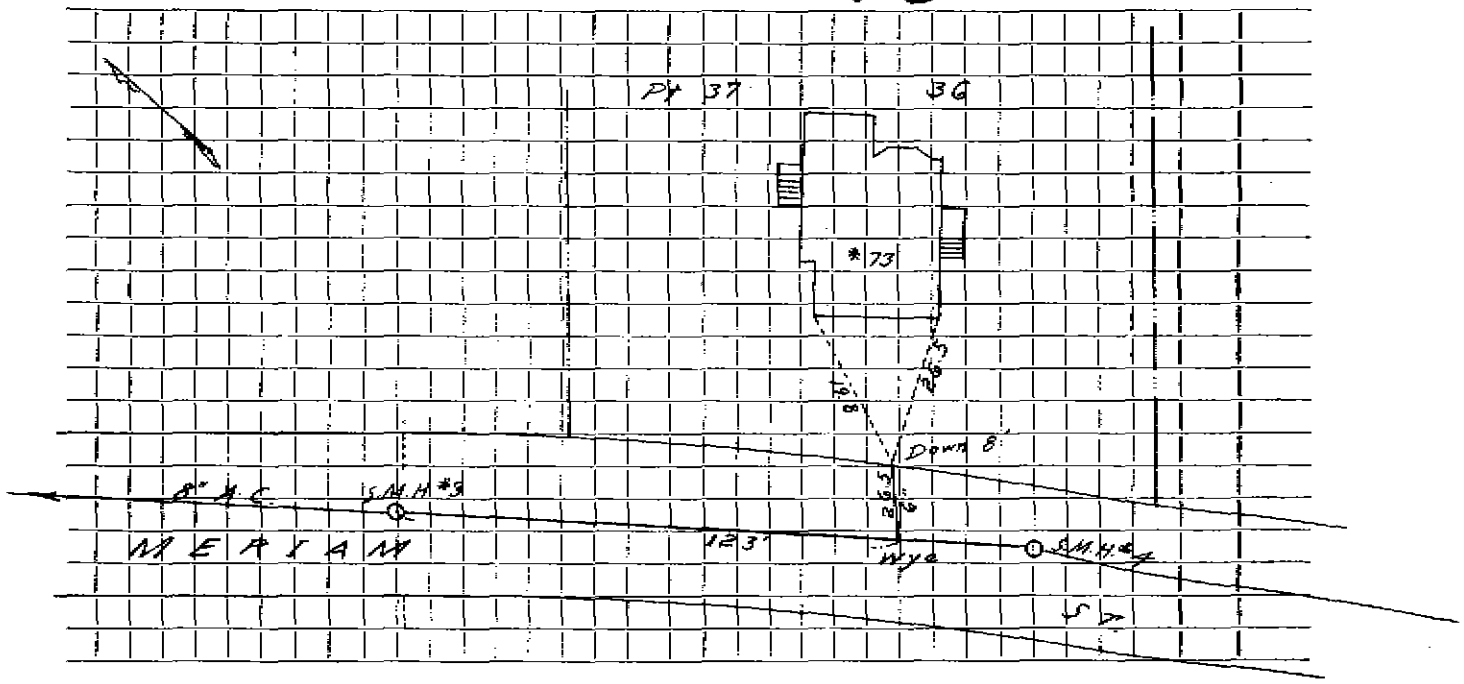

Connection made in ..... Street. Work completed .....

Remarks: .....

.....

.....