Name Earl Baldwin

Service No. 1977 16

Address ~~[illegible]~~ 77 Meriam Street

JUN 20 1977

Lots Pt. 38, Pt. 37

Location 77 Meriam St.

Kind of Pipe

Size

Size of Main

~~Repair Renewal~~ New Service

#3274

Location

Date		Material	Amount		Total		Date			Amount	
~~1969~~	~~27~~	~~6" Transite Pipe~~	@ 10.00		270	00	4/22/77		Deposit	270	00
12/6/77		30' of 6" ACP									
		10 - 4" CI						'69'			
								27'	6" Transite		

.N.18501

DATE _____

TOWN OF LEXINGTON — BOARD OF PUBLIC WORKS

SEWER DIVISION

Sketch of Service Here **77**

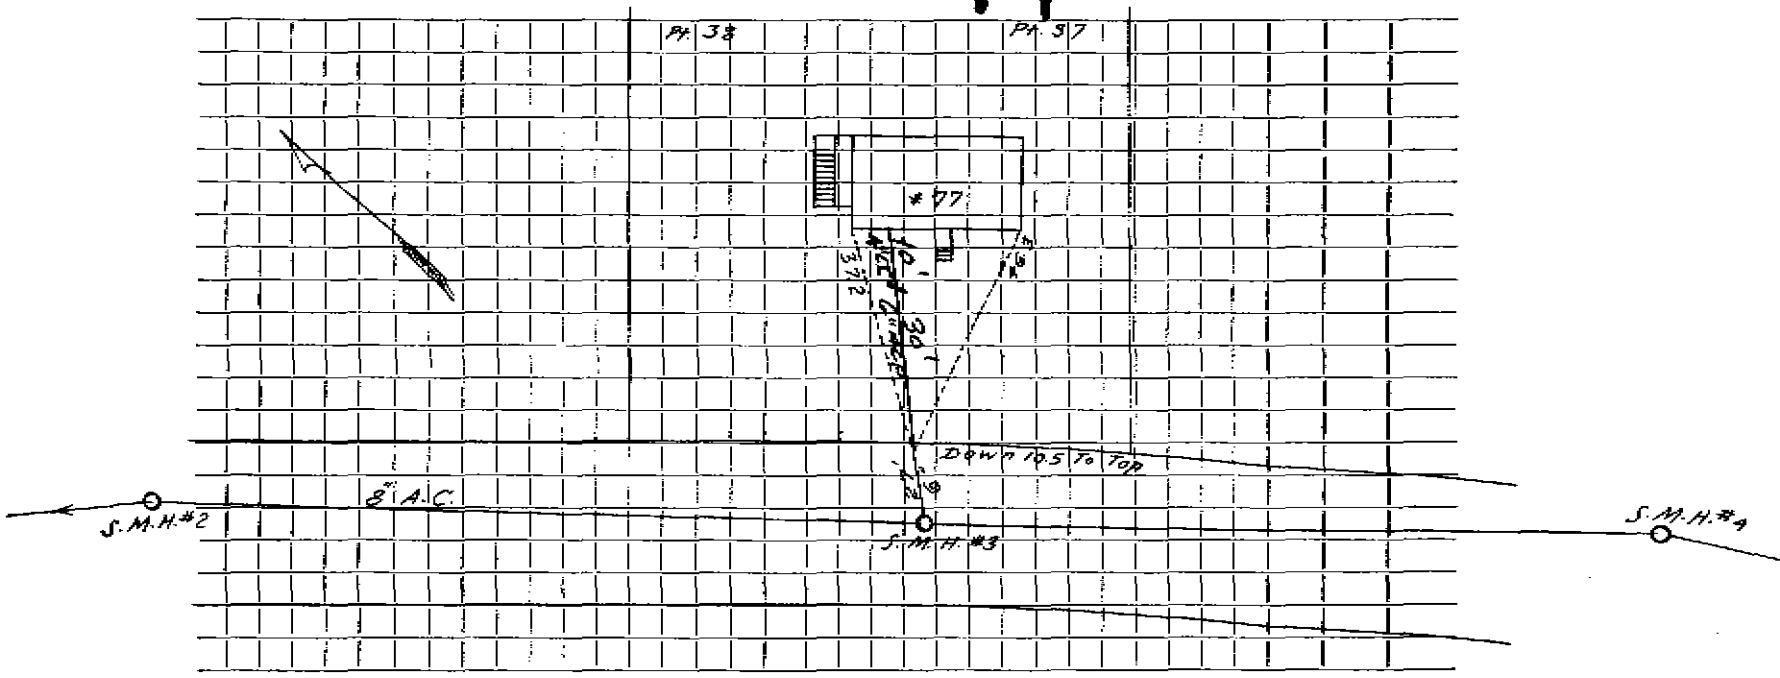

Connection made in ..... Street. Work completed .....

Remarks: .....

.....

.....