Name

Service No. 3013

Address 85 Meriam ST

Location LoT 42

Kind of Pipe PVC

Size 6"

Size of Main 8" V.C.

Repair—Renewal—New Service

Location

Date		Material	Amount	Total	Date		Amount
9/10/08	6'	Sch 40					
	50'	6" PVC					
	1	4"x6 Ferrnco					
	1	6"- PVC x AS. Ferrnco 5' Dwn					
		Exist					
8/1/67	33'	6" Transite Pipe					

DATE _____

TOWN OF LEXINGTON — BOARD OF PUBLIC WORKS

SEWER DIVISION

Sketch of Service Here

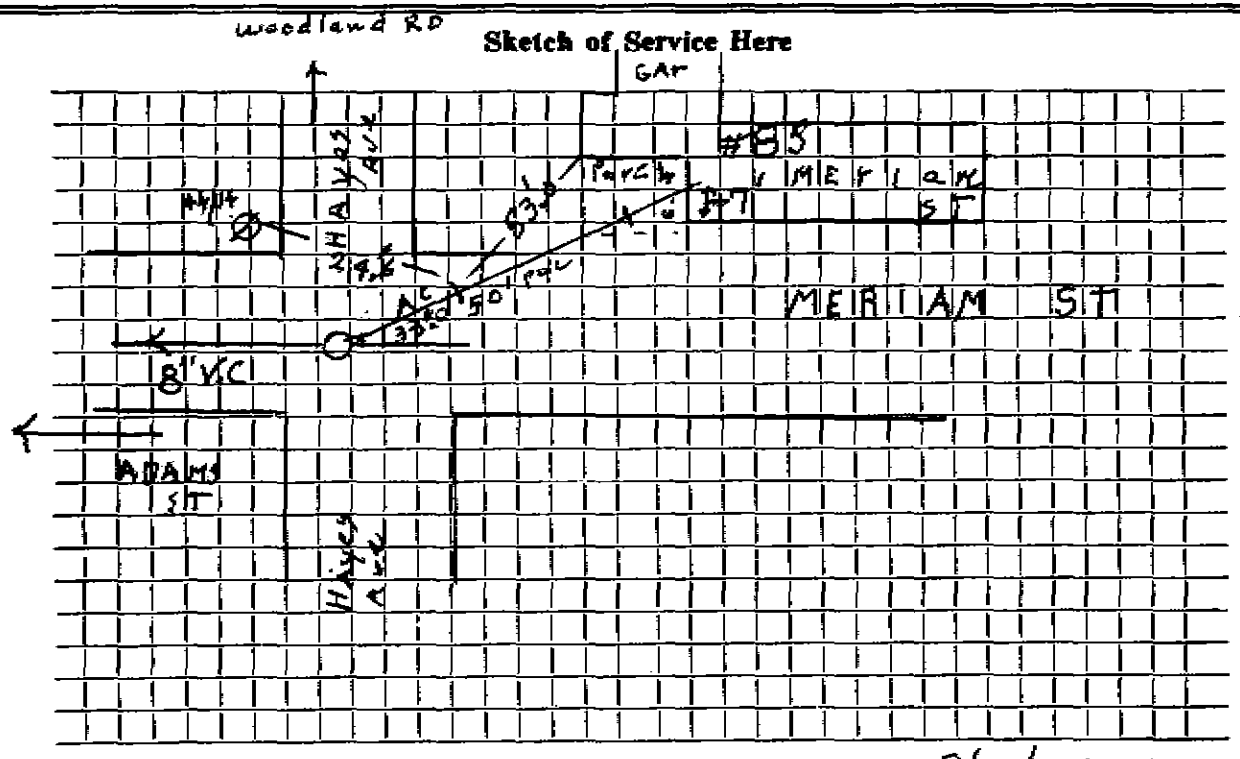

Connection made in ..... Street. Work completed 9/10/08 J. McLaughlin

Remarks: .....

.....

.....